



**TOTAL SF AVAILABLE -24,300 SF**

OFFICE - 800 SF  
WAREHOUSE SF - 23,500 SF

[Click to access 3D model](#)

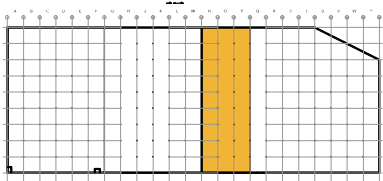

Key Plan

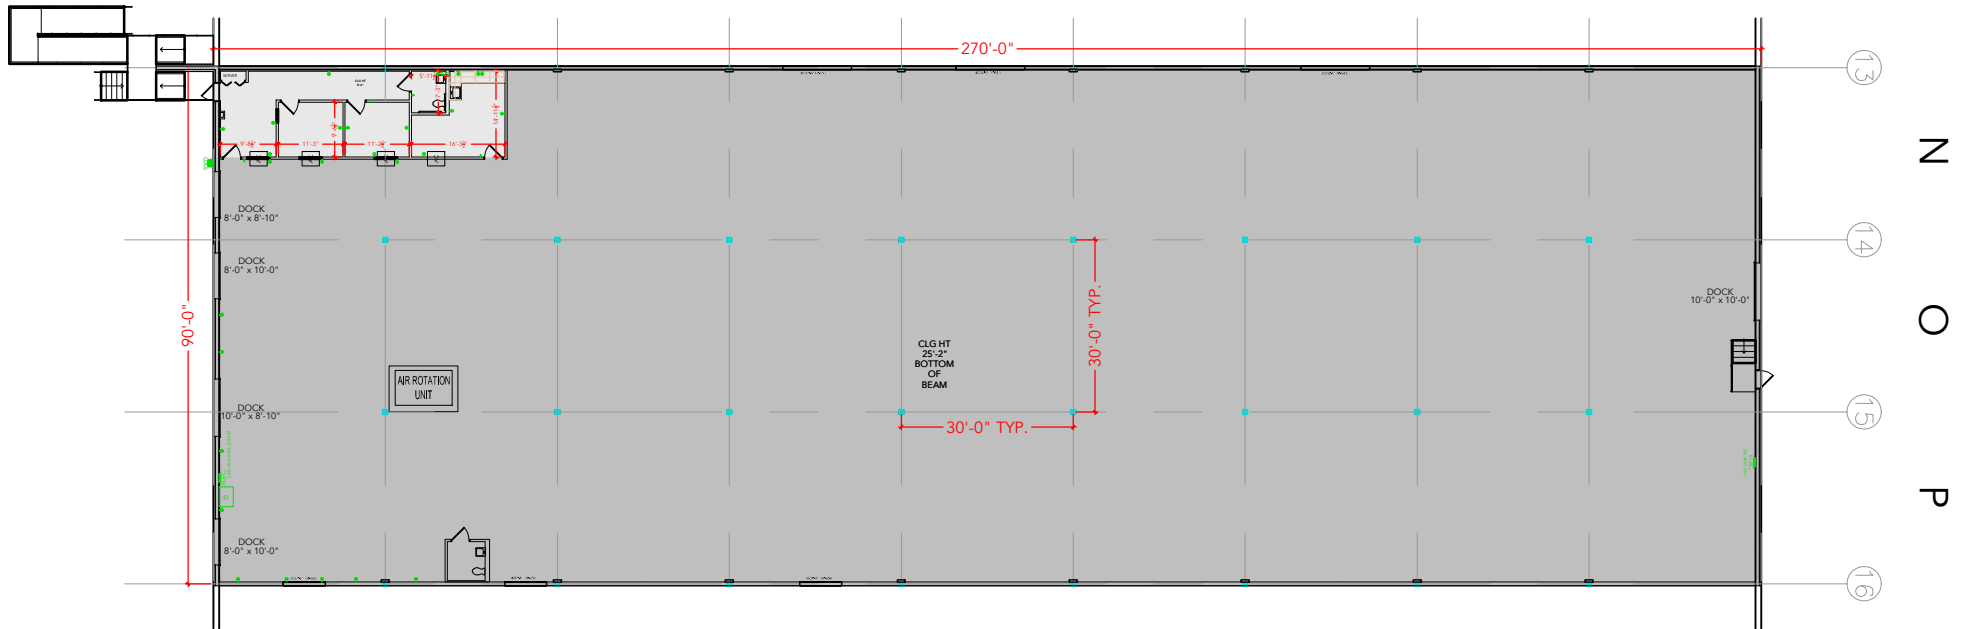

## Floor Plan