


TOTAL SF AVAILABLE - 84,700 RSF


OFFICE - 0,000 SF

WAREHOUSE - 84,700 SF

[Click to access 3D model](#)

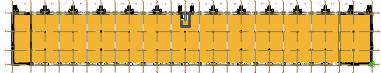

Key Plan

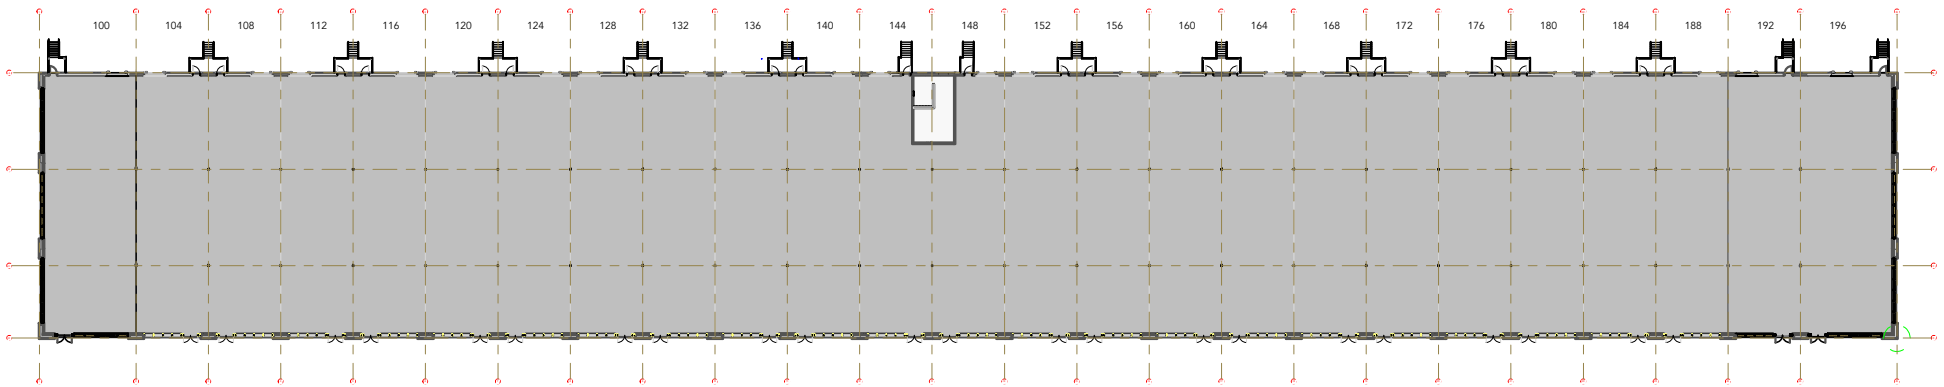

Floor Plan