


TOTAL SF AVAILABLE - 30,977 RSF



Key Plan

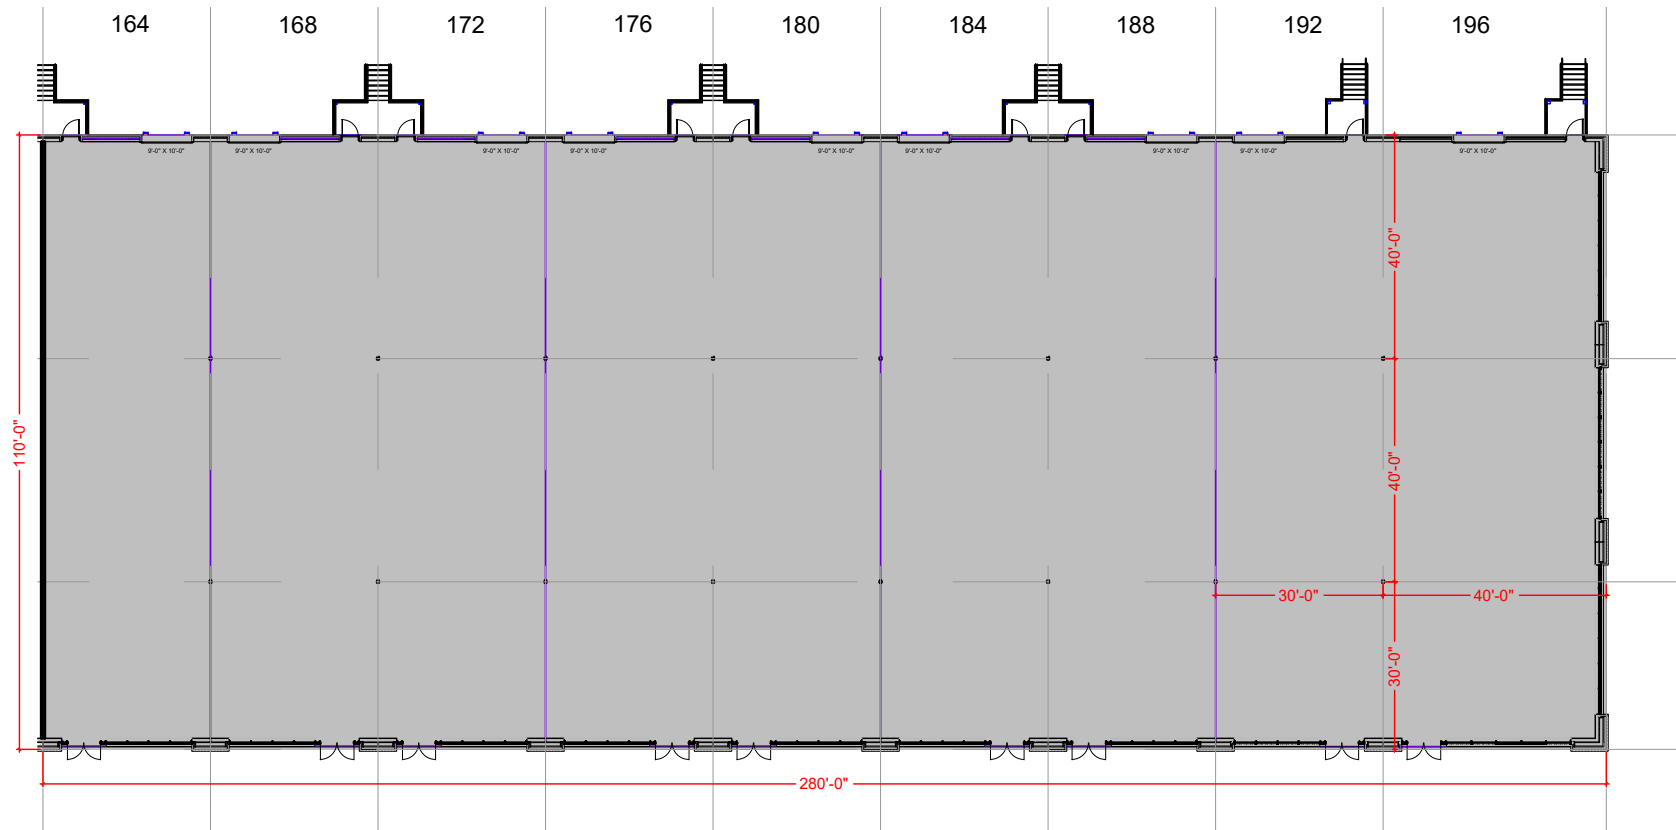

Floor Plan