



TOTAL SF AVAILABLE - 51,259 RSF
INCLUDES % OF MECH. ROOM

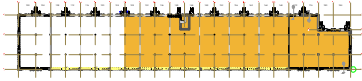

Key Plan

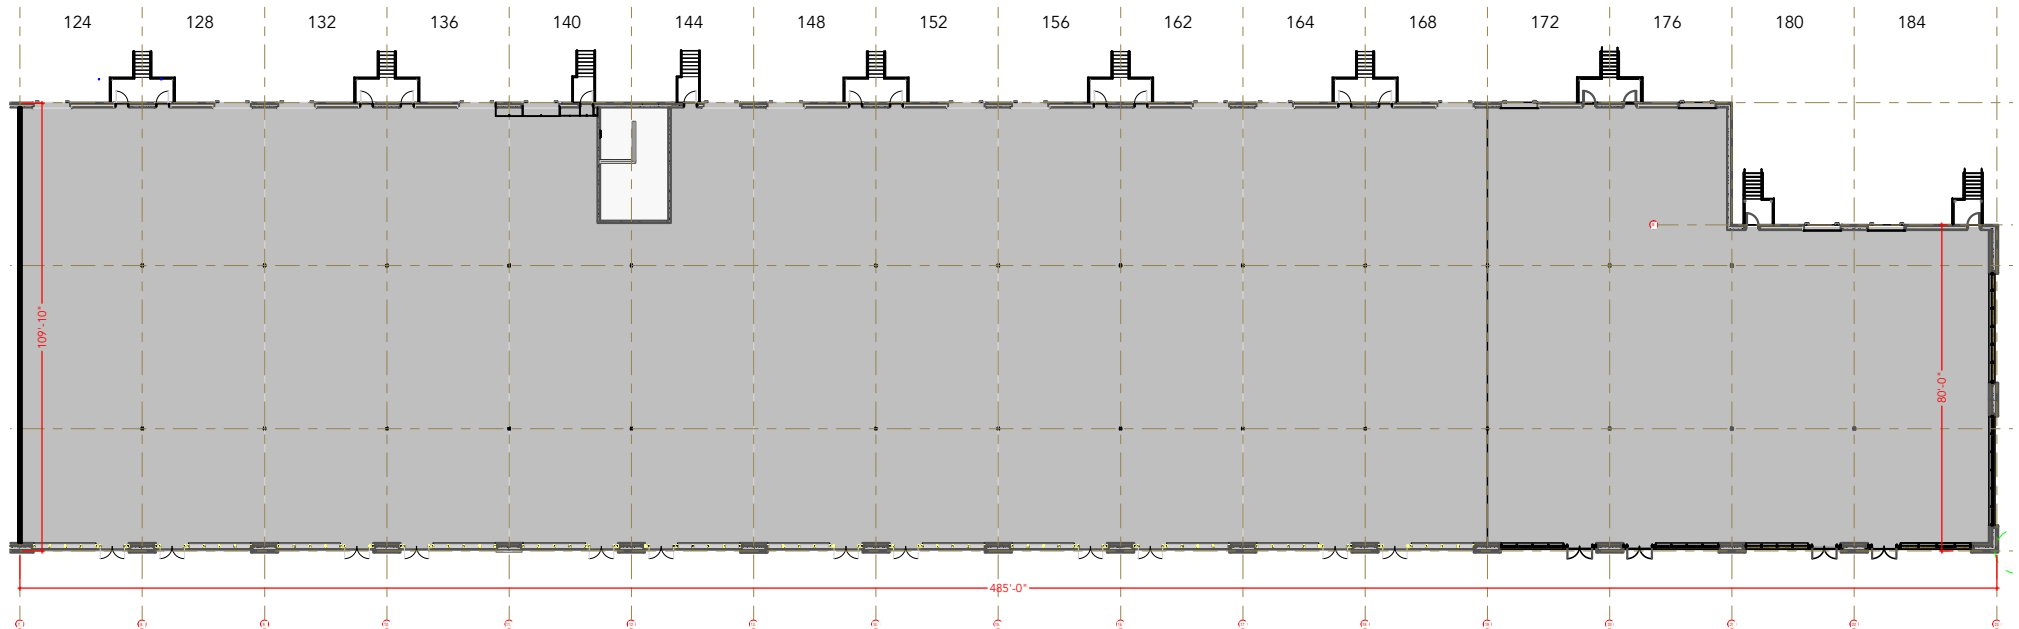

Floor Plan