


Key Plan

TOTAL SF AVAILABLE - 6,382 RSF
(INCLUDES % OF MECH. RM)

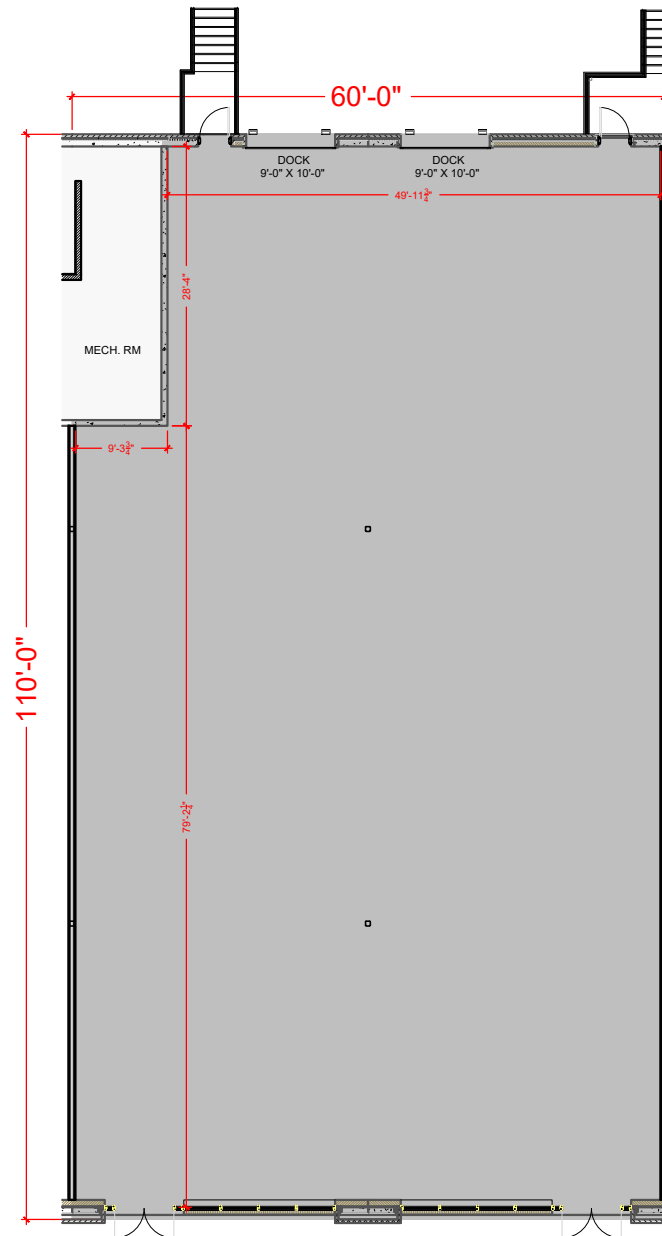

Floor Plan