



TOTAL SF AVAILABLE - 25,173 RSF
* INCLUDED % OF MECH. ROOM

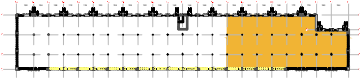

Key Plan

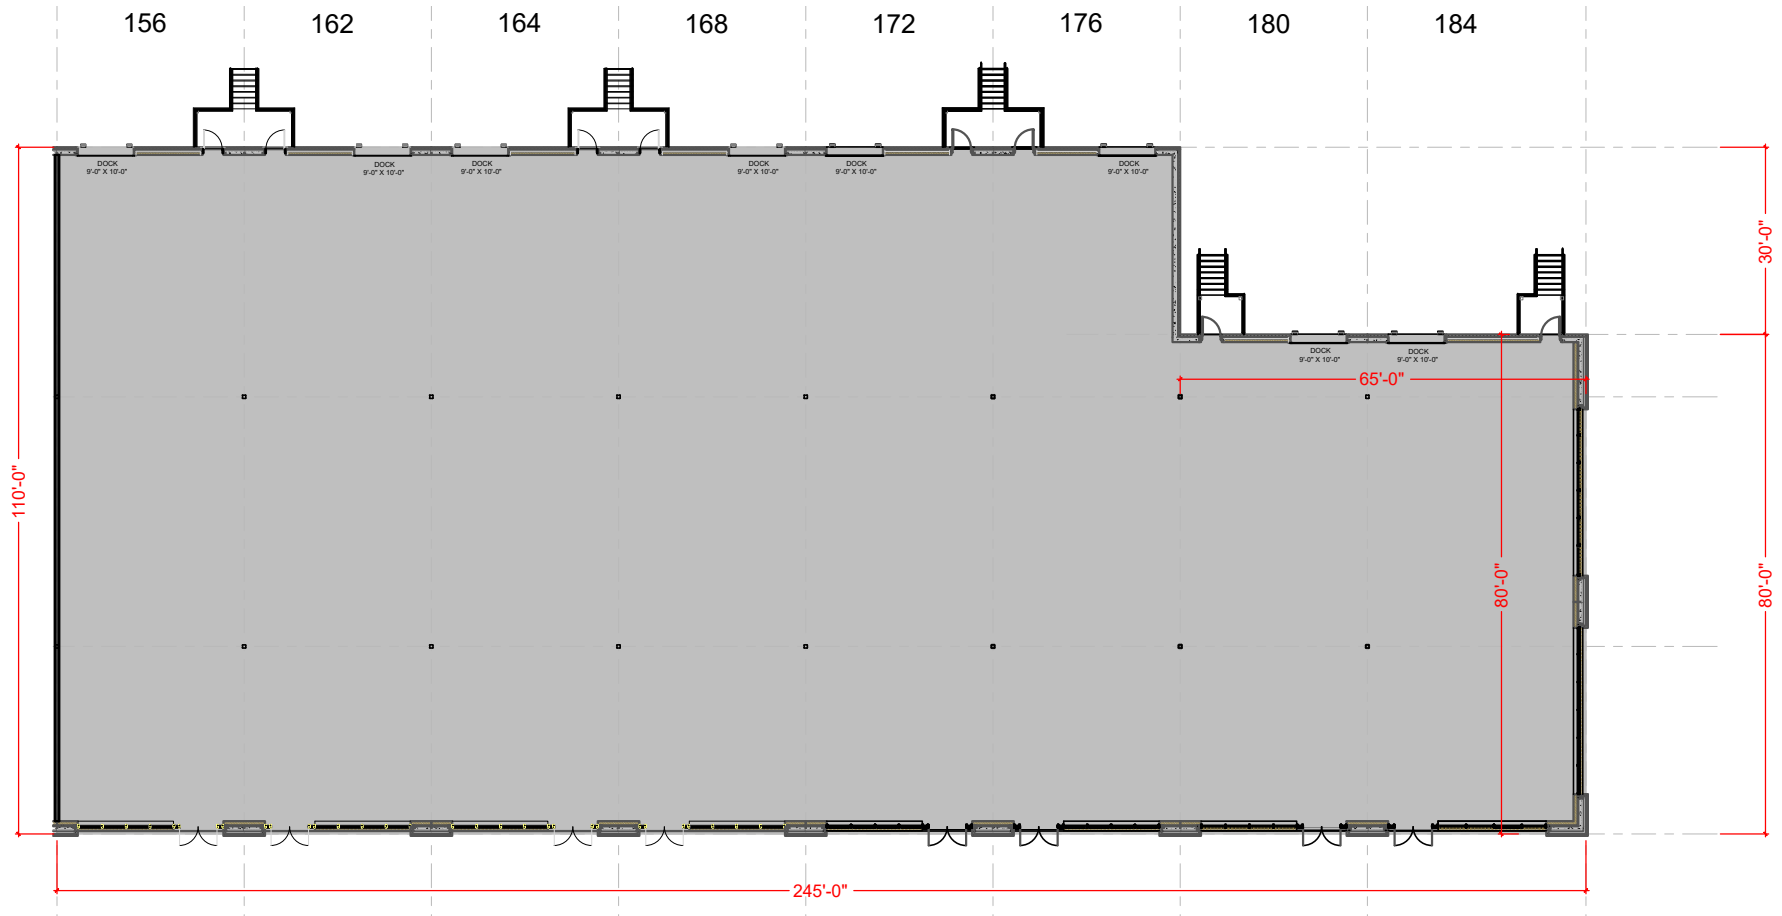

Floor Plan