


TOTAL SF AVAILABLE - 47,222 RSF


OFFICE - 0,000 SF

WAREHOUSE - 47,222 RSF

*INCLUDING % OF MECH. ROOM
[Click to access 3D model](#)

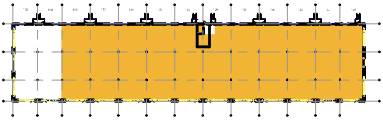

Key Plan

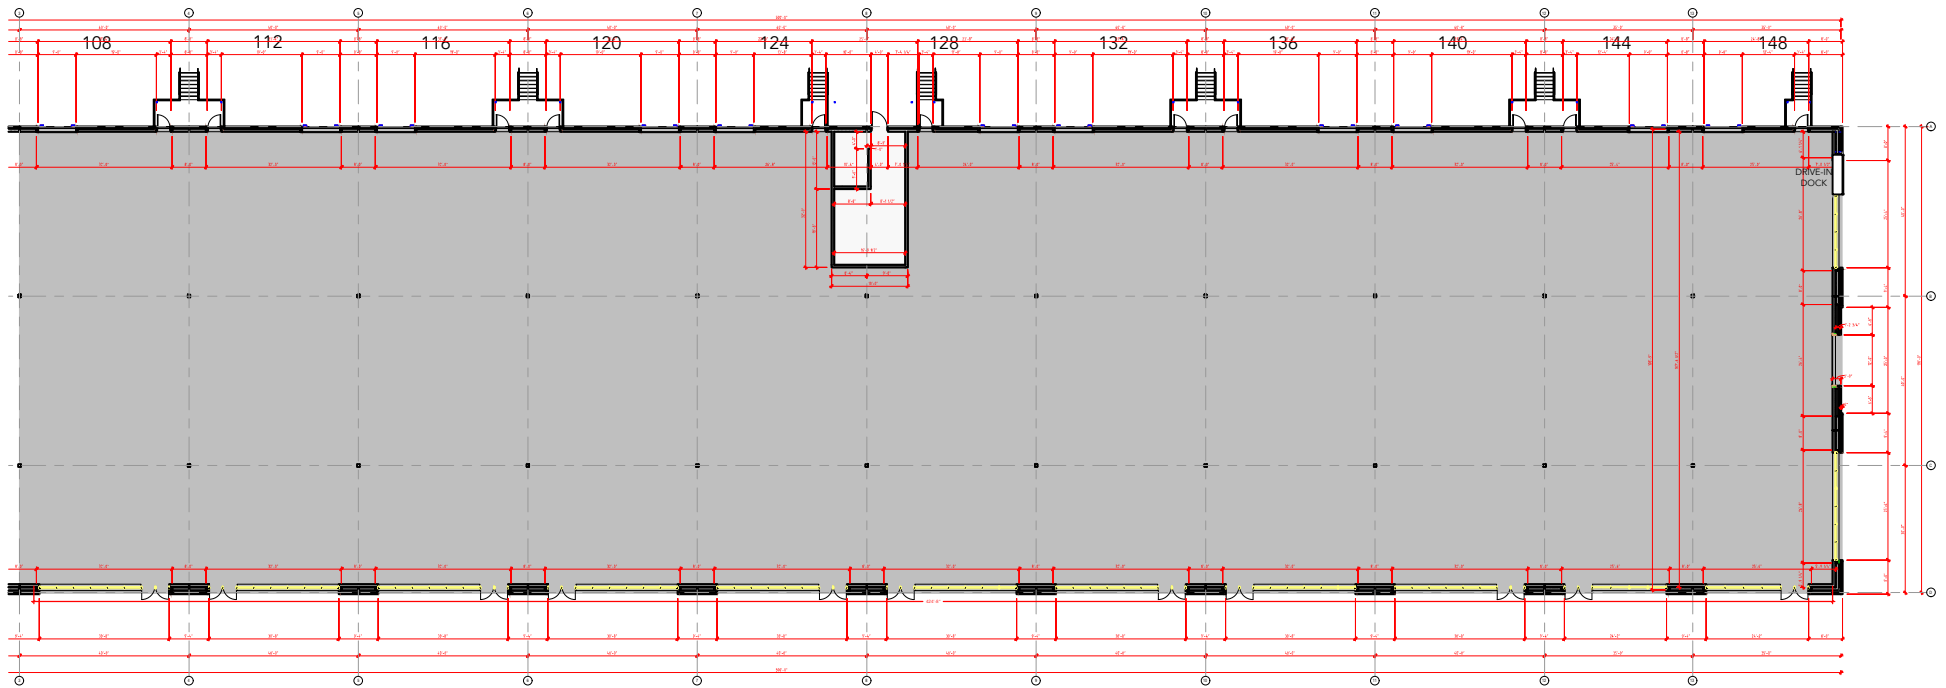

Floor Plan