


TOTAL SF AVAILABLE -72,600 SF


OFFICE - 0,000 SF

WAREHOUSE - 72,600 SF

[Click to access 3D model](#)

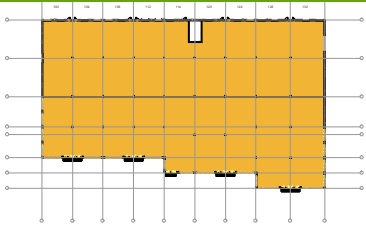

Key Plan

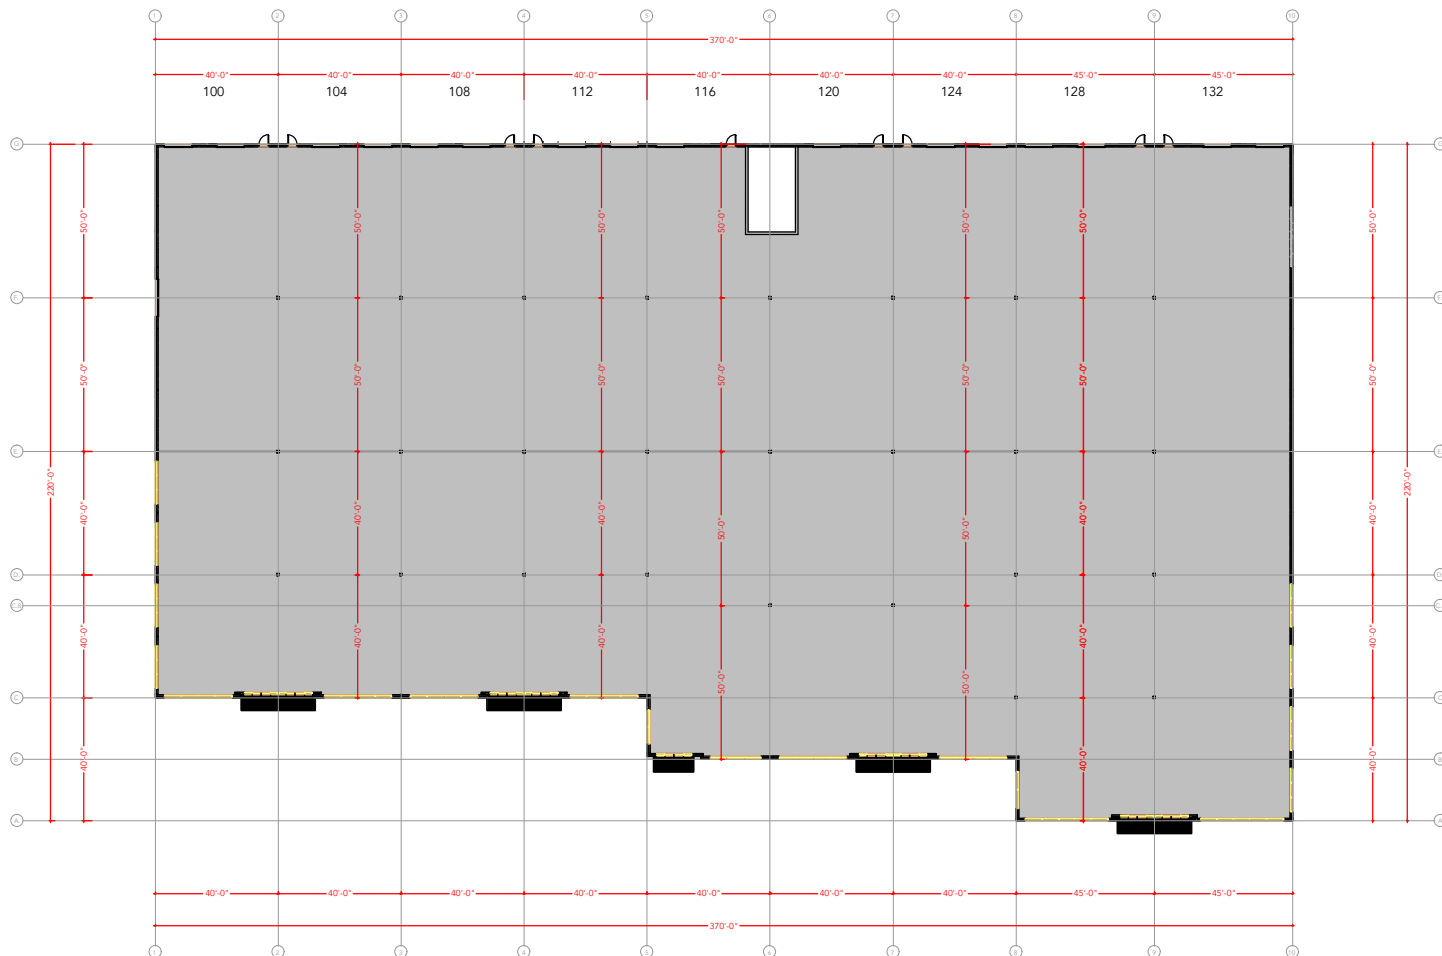

Floor Plan