



TOTAL SF AVAILABLE - 8,289 SF

OFFICE - 1,112 SF

WAREHOUSE SF - 7,211 SF

[Click to access 3D model](#)

Key Plan

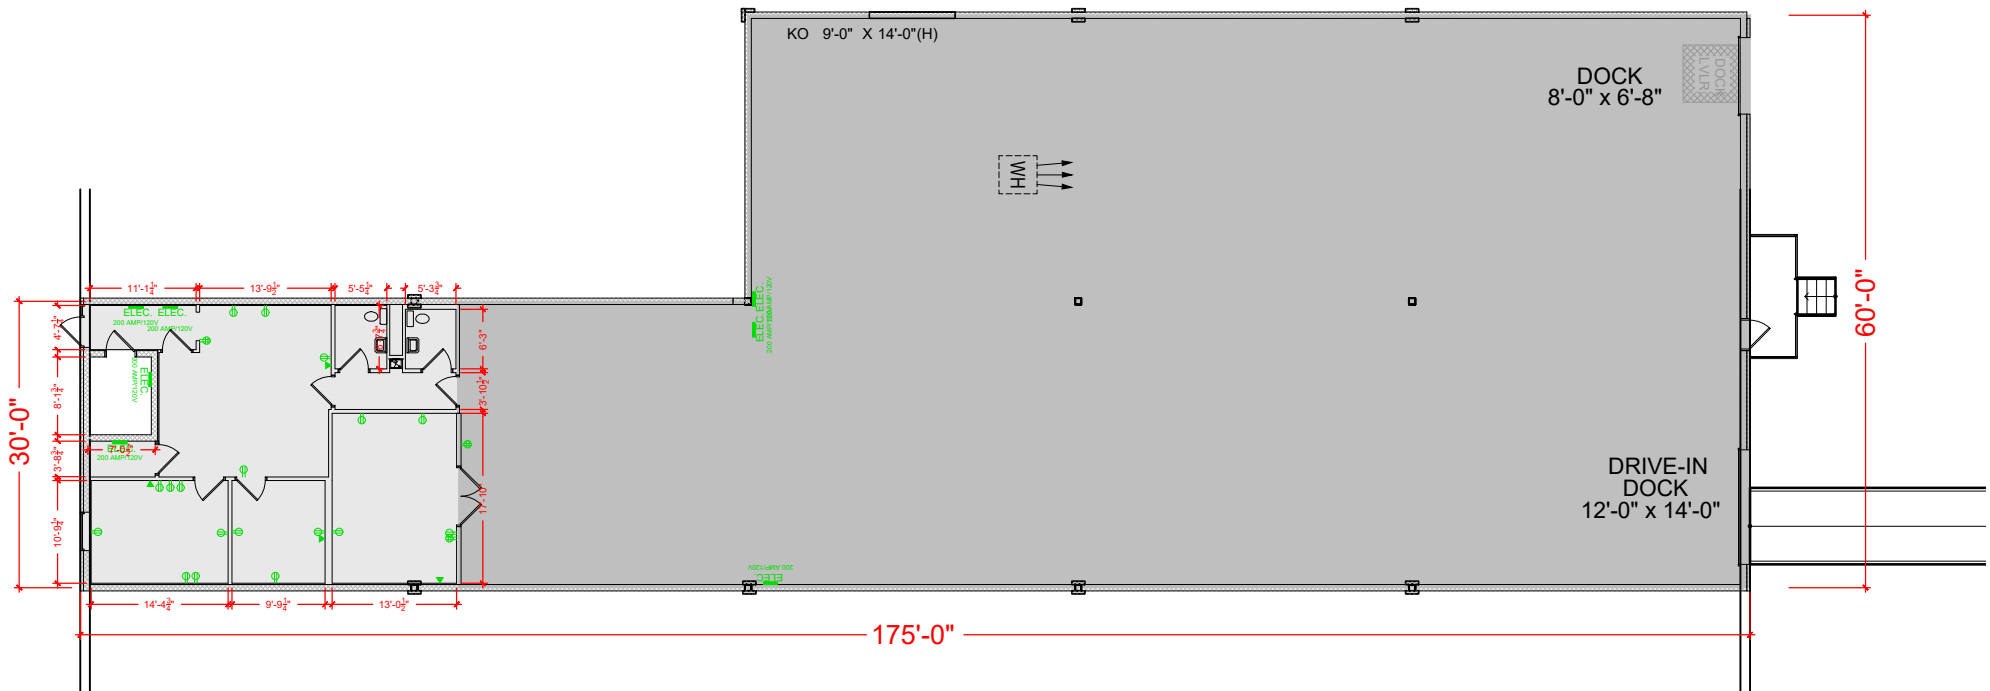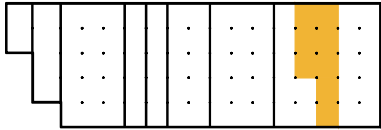

Floor Plan