


TOTAL SF AVAILABLE - 7,350 SF


OFFICE - 711 SF

WAREHOUSE SF - 6,639 SF

[Click to access CADD file](#)

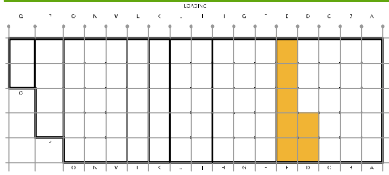

Key Plan

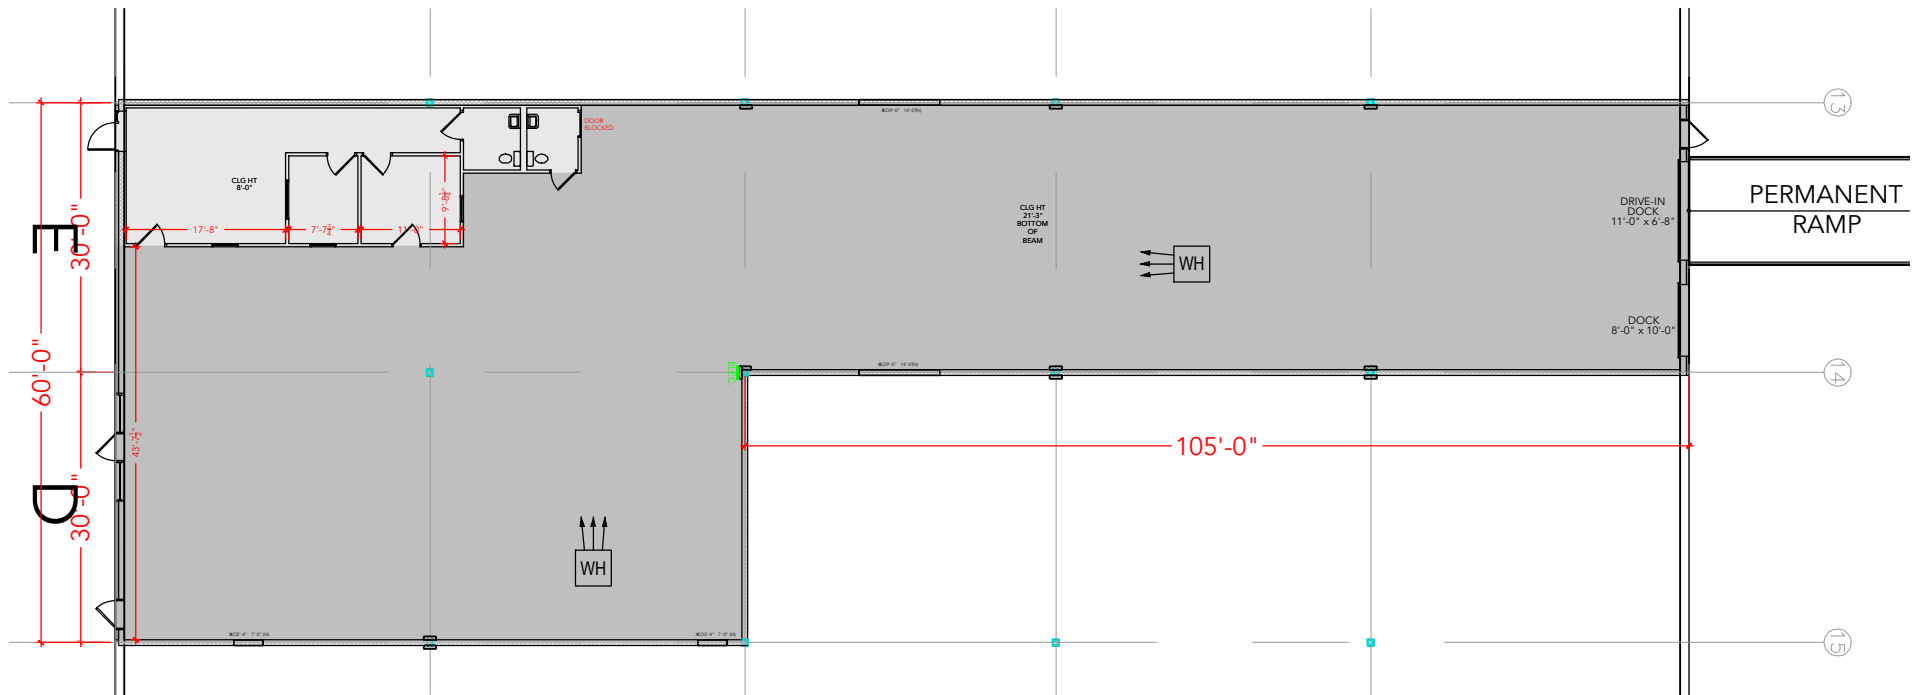

Floor Plan