


TOTAL SF AVAILABLE -5,250 SF


OFFICE - 1,938 SF

WAREHOUSE - 3,312 SF

[Click to access 3D model](#)

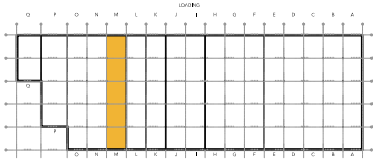

Key Plan

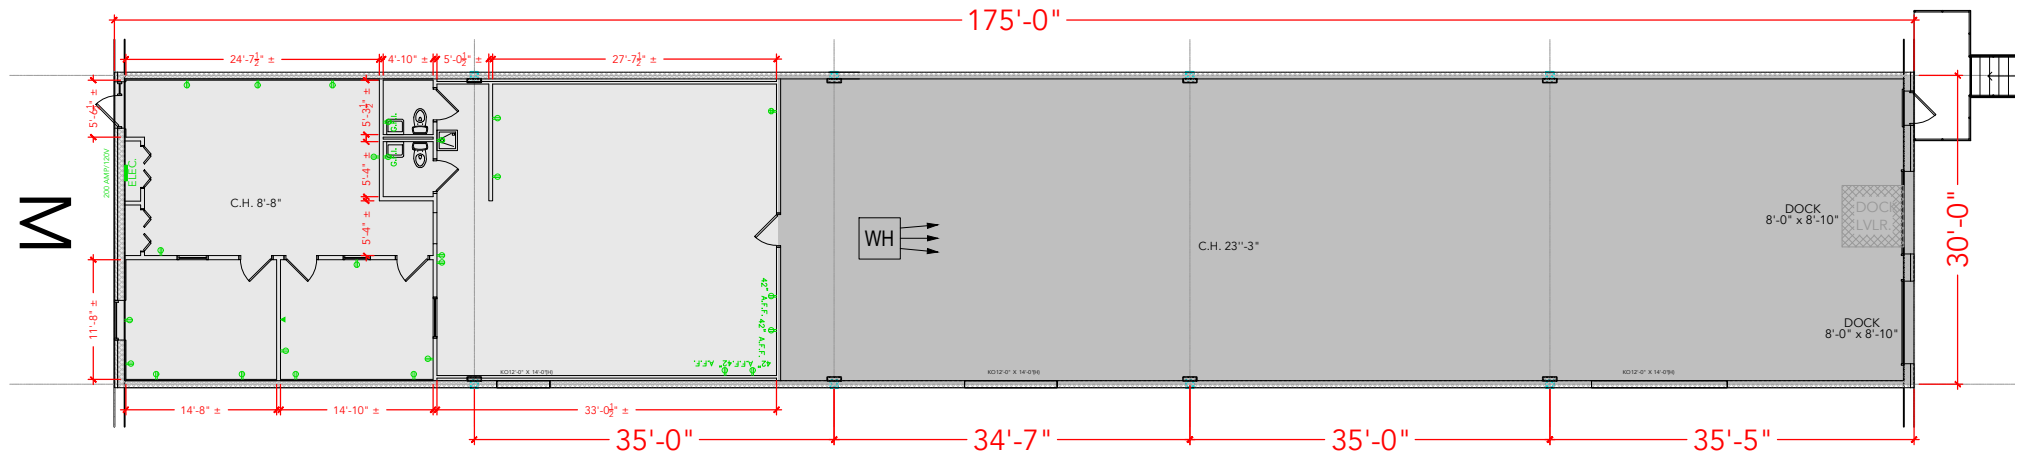

Floor Plan