


TOTAL SF AVAILABLE -2,596 RSF

OFFICE - 435 RSF


WAREHOUSE - 2,161 RSF

* INCLUDES % OF METER ROOM

[Click to access CADD file](#)

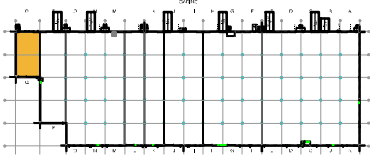

Key Plan

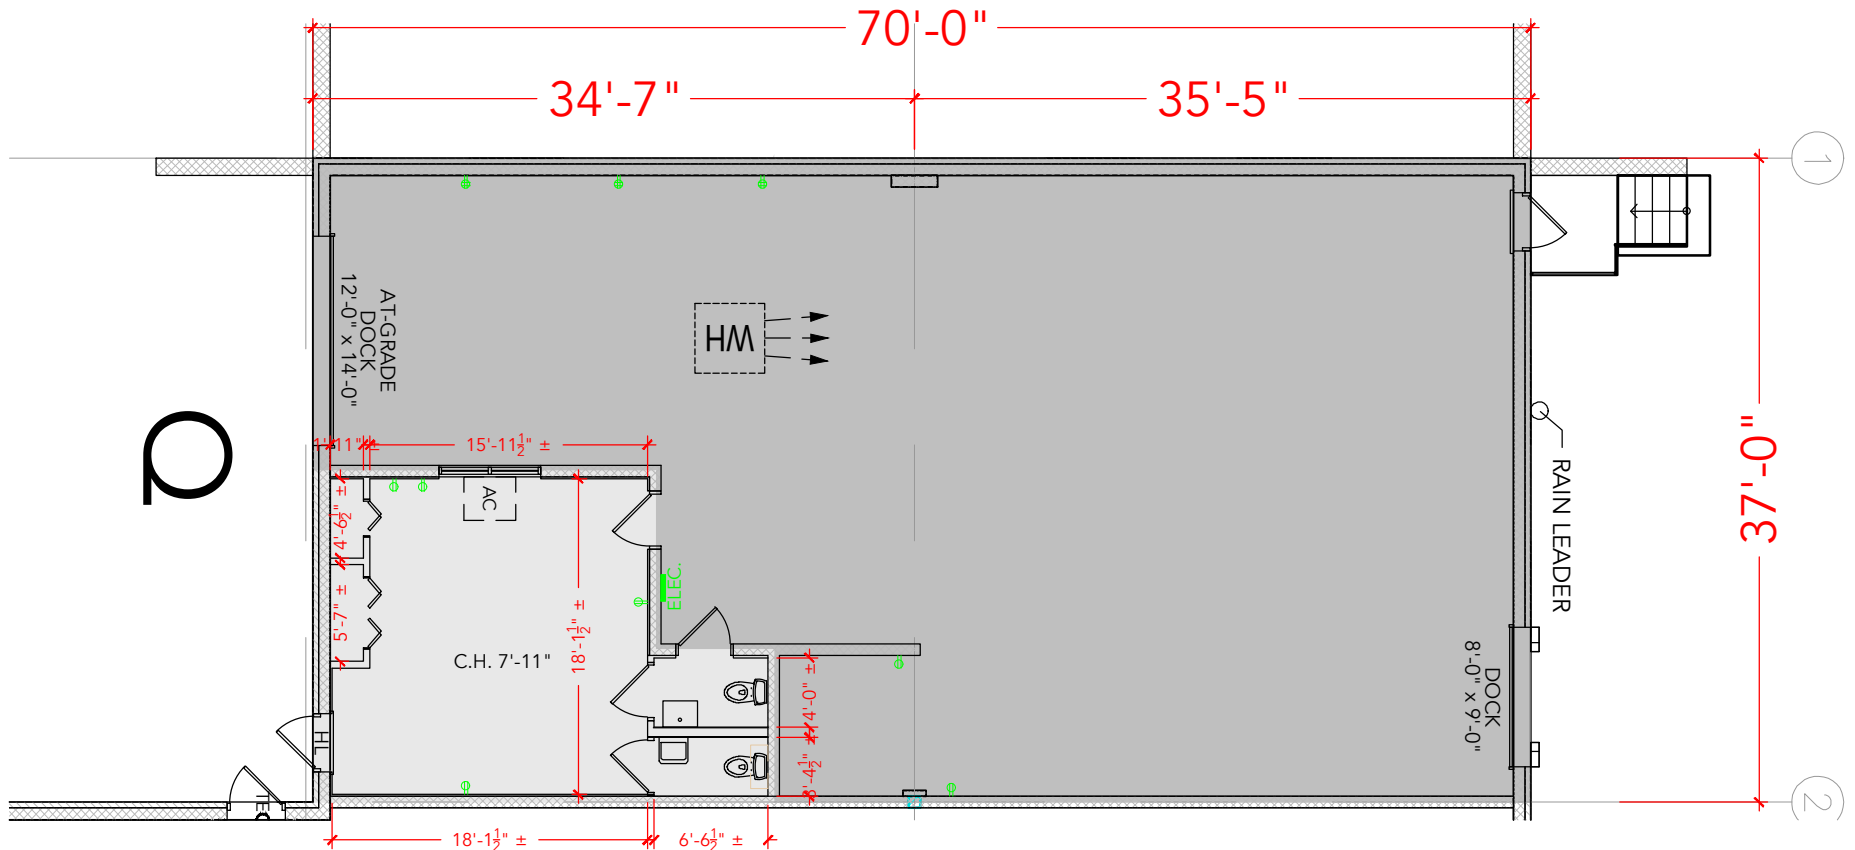

Floor Plan