



TOTAL SF AVAILABLE - 24,248 RSF

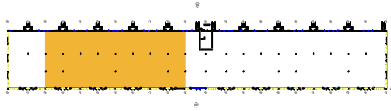

Key Plan

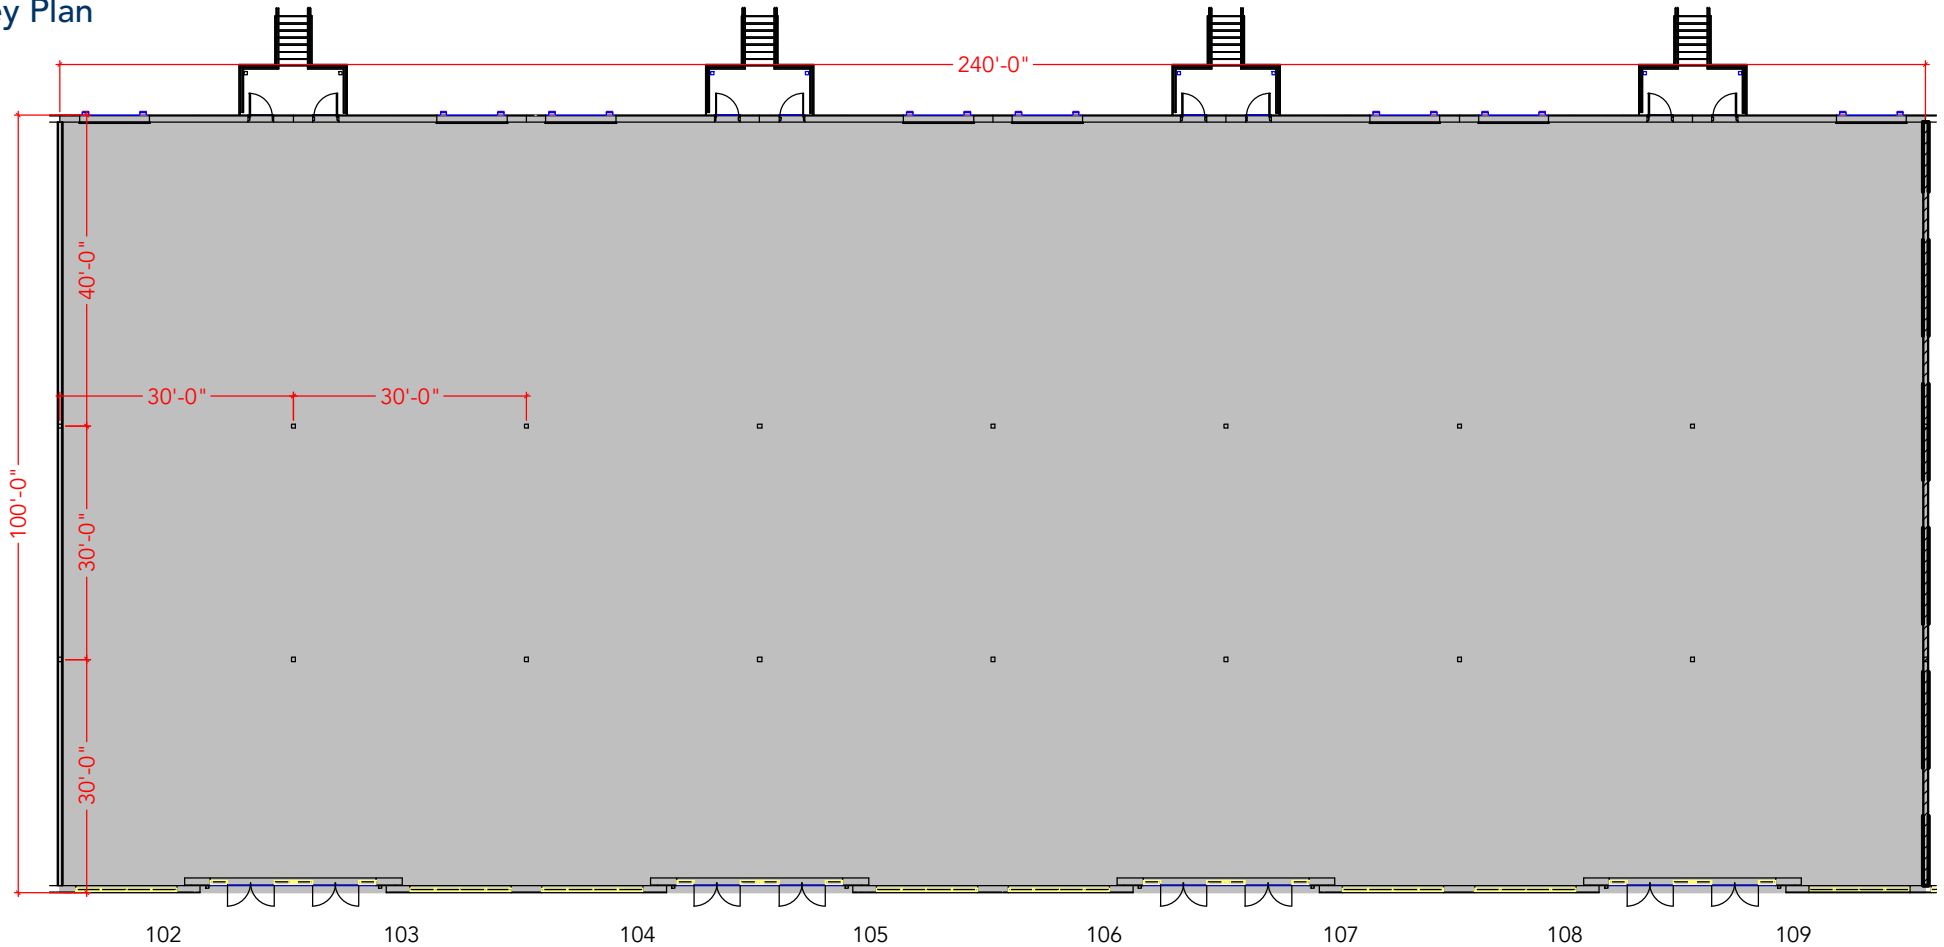

Floor Plan