


TOTAL SF AVAILABLE - 9,093 RSF


OFFICE - 0,000 SF

WAREHOUSE - 9,093 RSF

[Click to access CADD file](#)

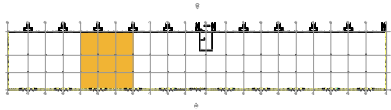

Key Plan

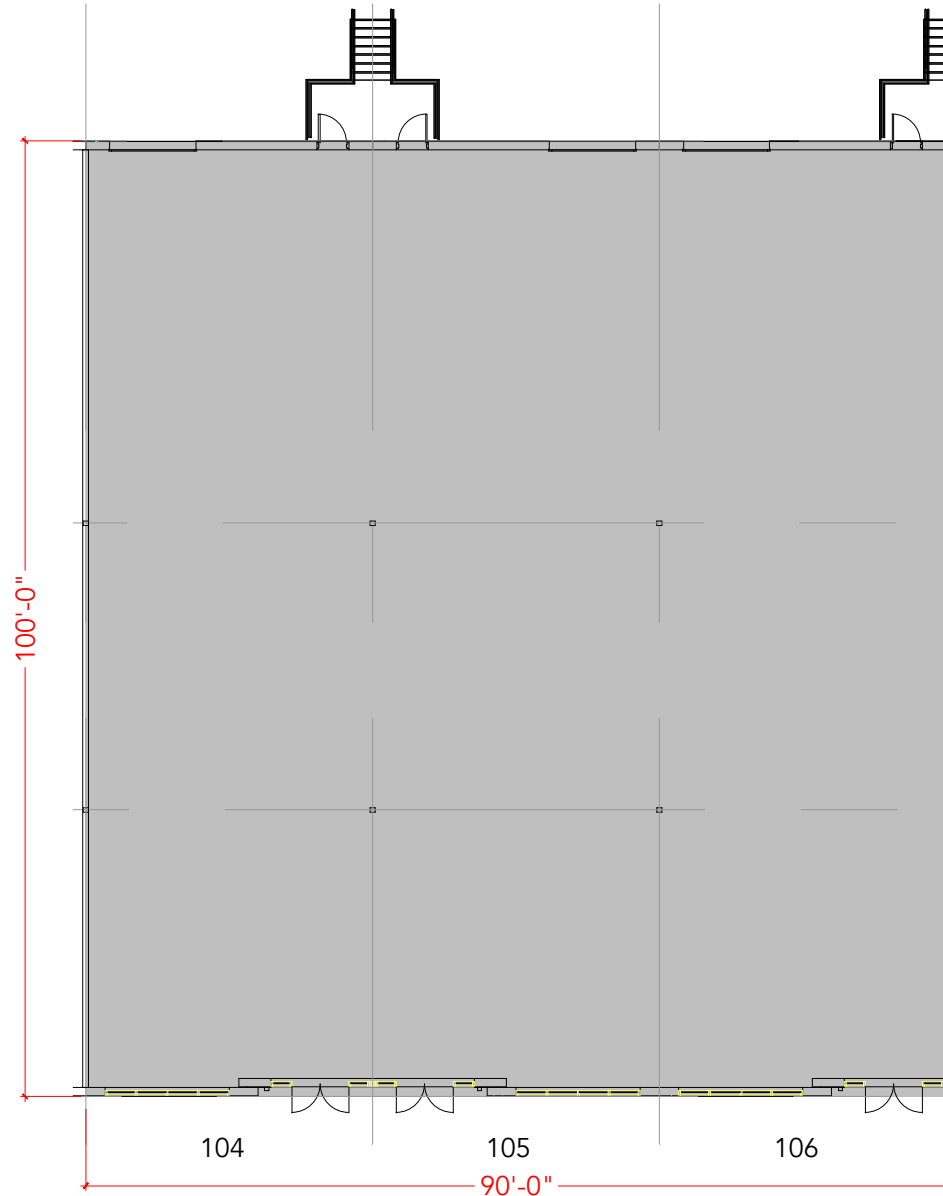

Floor Plan