


TOTAL SF AVAILABLE - 18,357 RSF


OFFICE - 0 RSF

WAREHOUSE - 18,357 RSF

[Click to access CADD file](#)

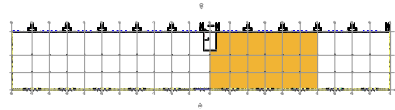

Key Plan

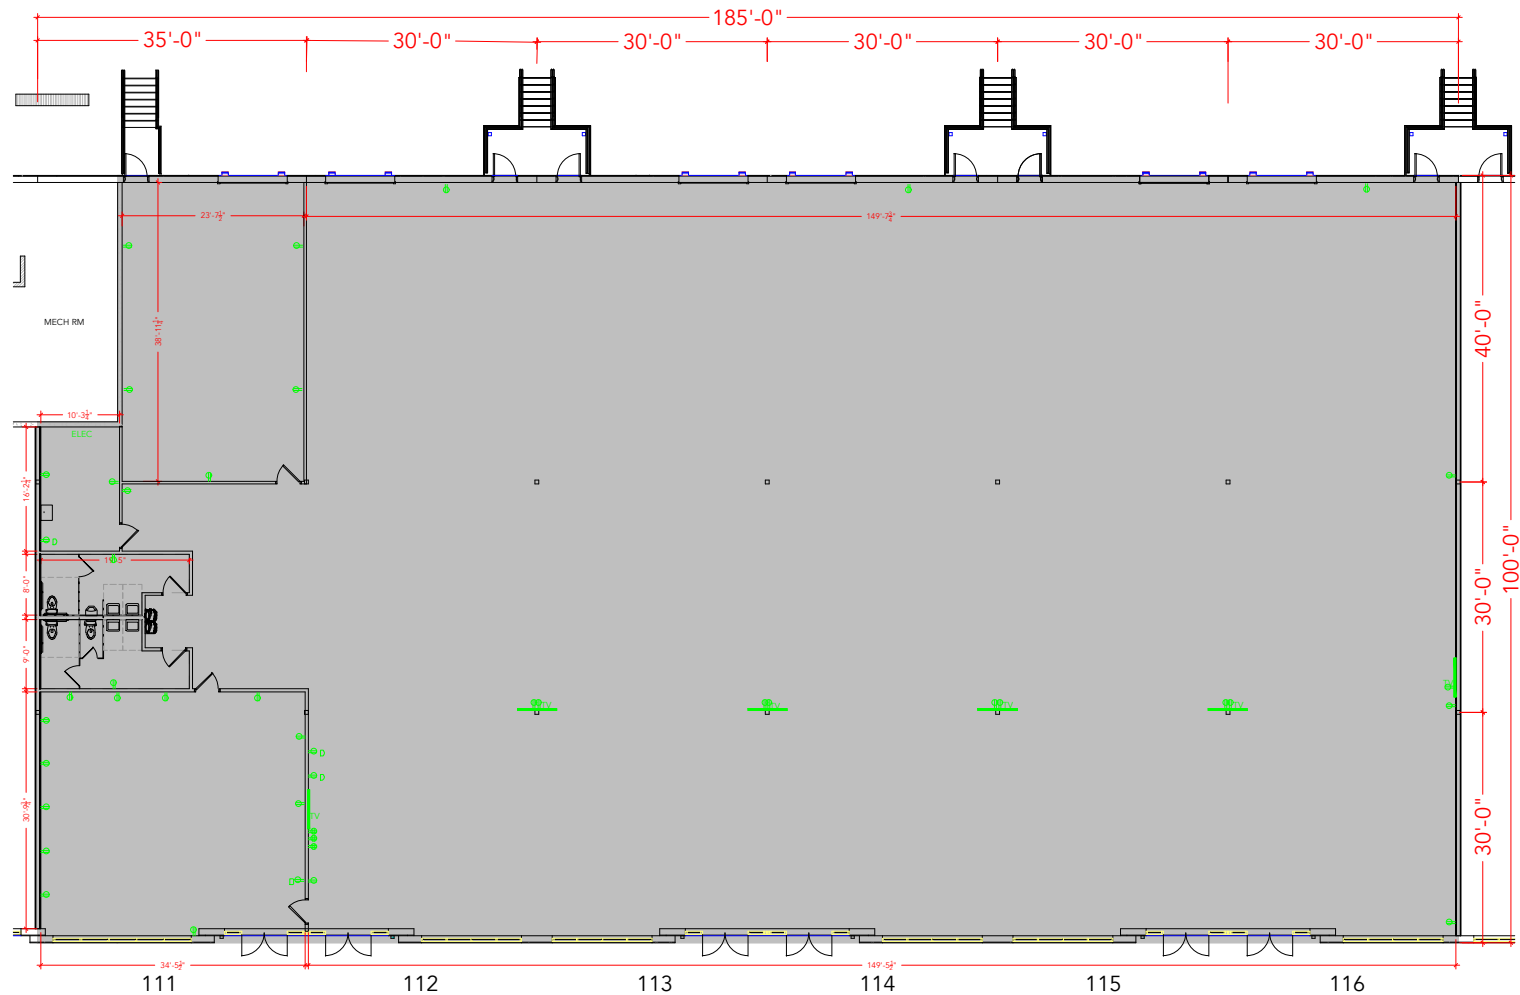

Floor Plan