


**TOTAL SF AVAILABLE - 18,357 RSF**


**OFFICE - 0 RSF**

**WAREHOUSE - 18,357 RSF**

[Click to access CADD file](#)

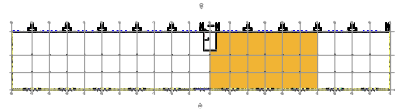

**Key Plan**

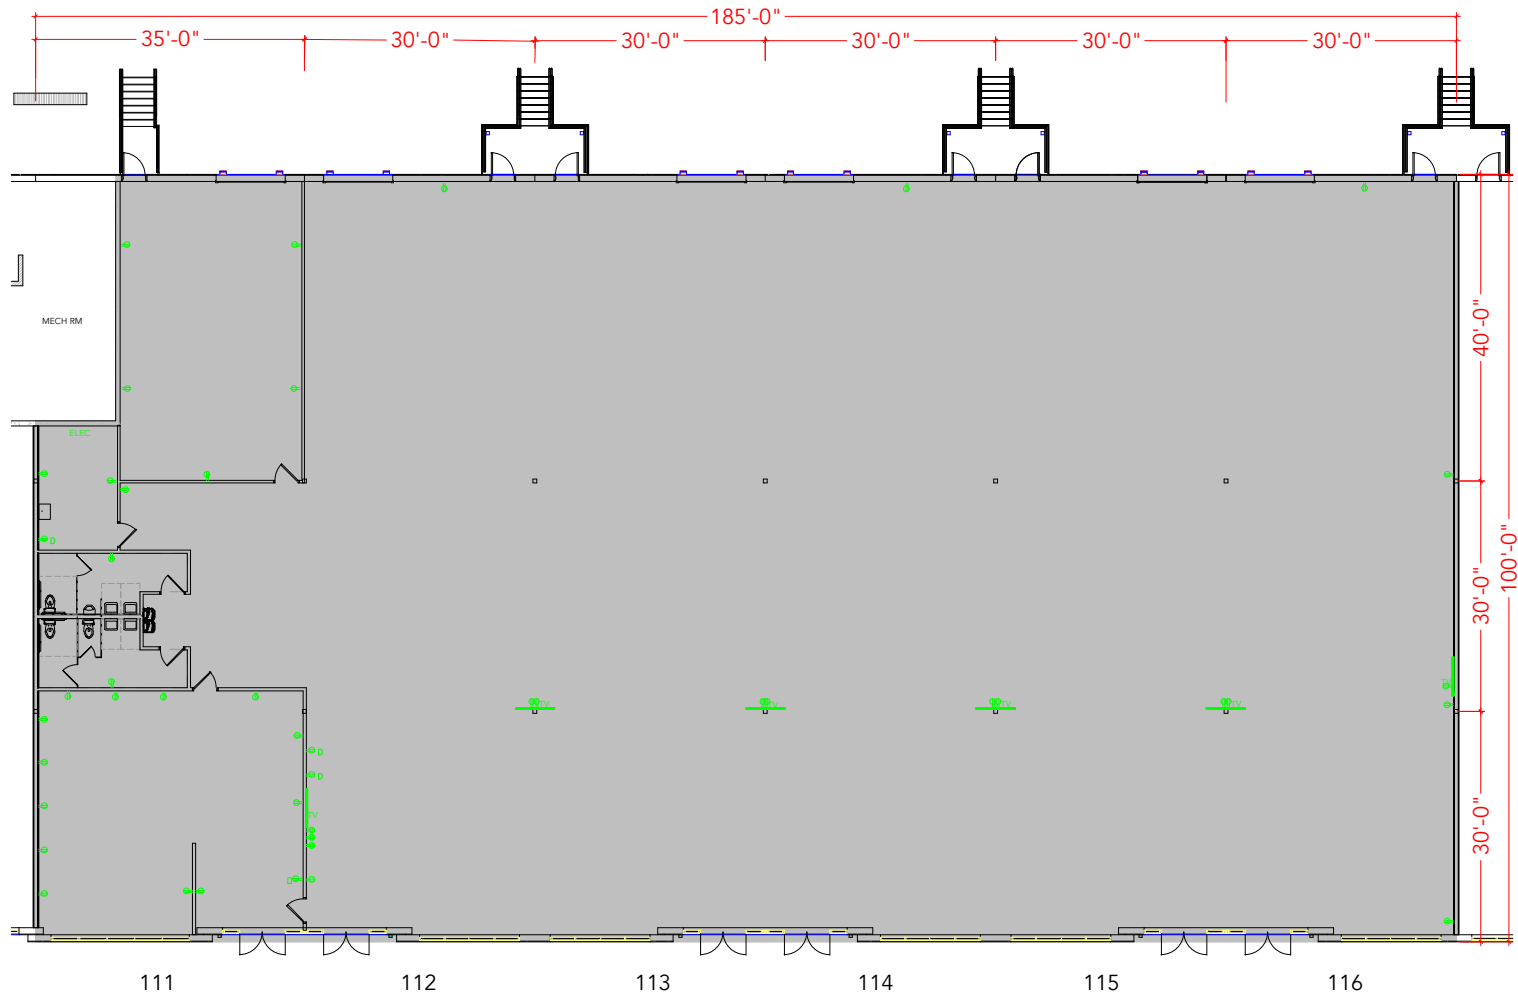

**Floor Plan**