


TOTAL SF AVAILABLE - 12,629 RSF


OFFICE - 508 RSF

WAREHOUSE - 12,121 RSF

[Click to access CADD file](#)

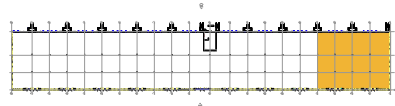

Key Plan

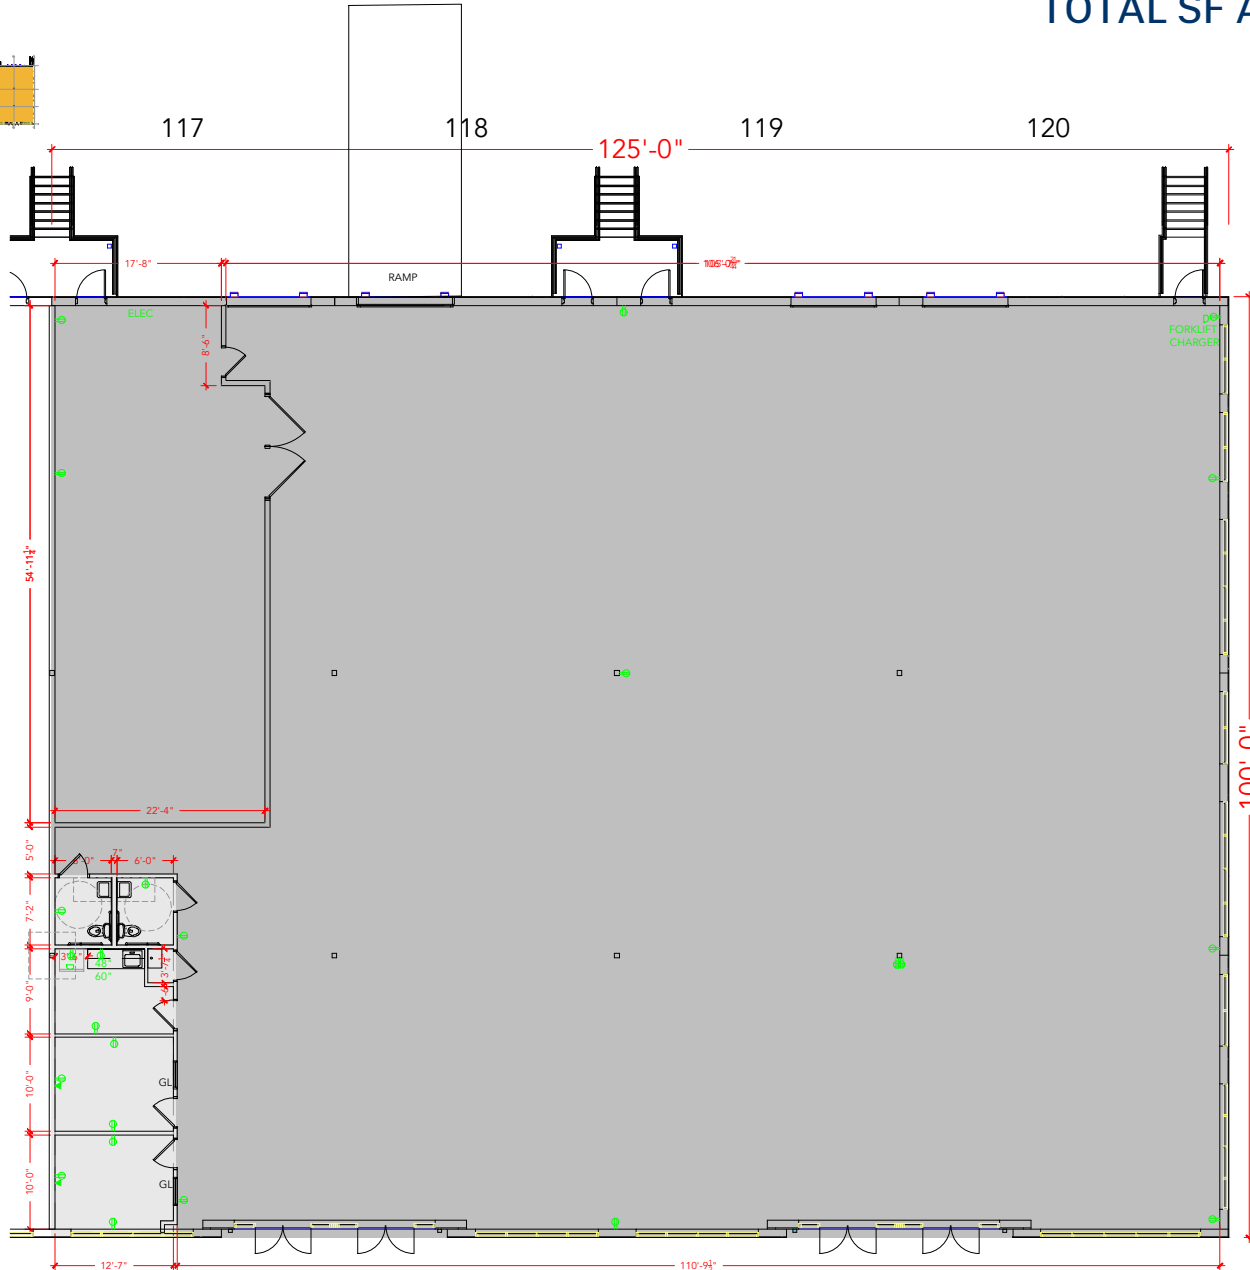

Floor Plan