


TOTAL SF AVAILABLE - 82,995 RSF

OFFICE - 0,000 SF

WAREHOUSE - 82,995 RSF

[Click to access CADD file](#)

Key Plan

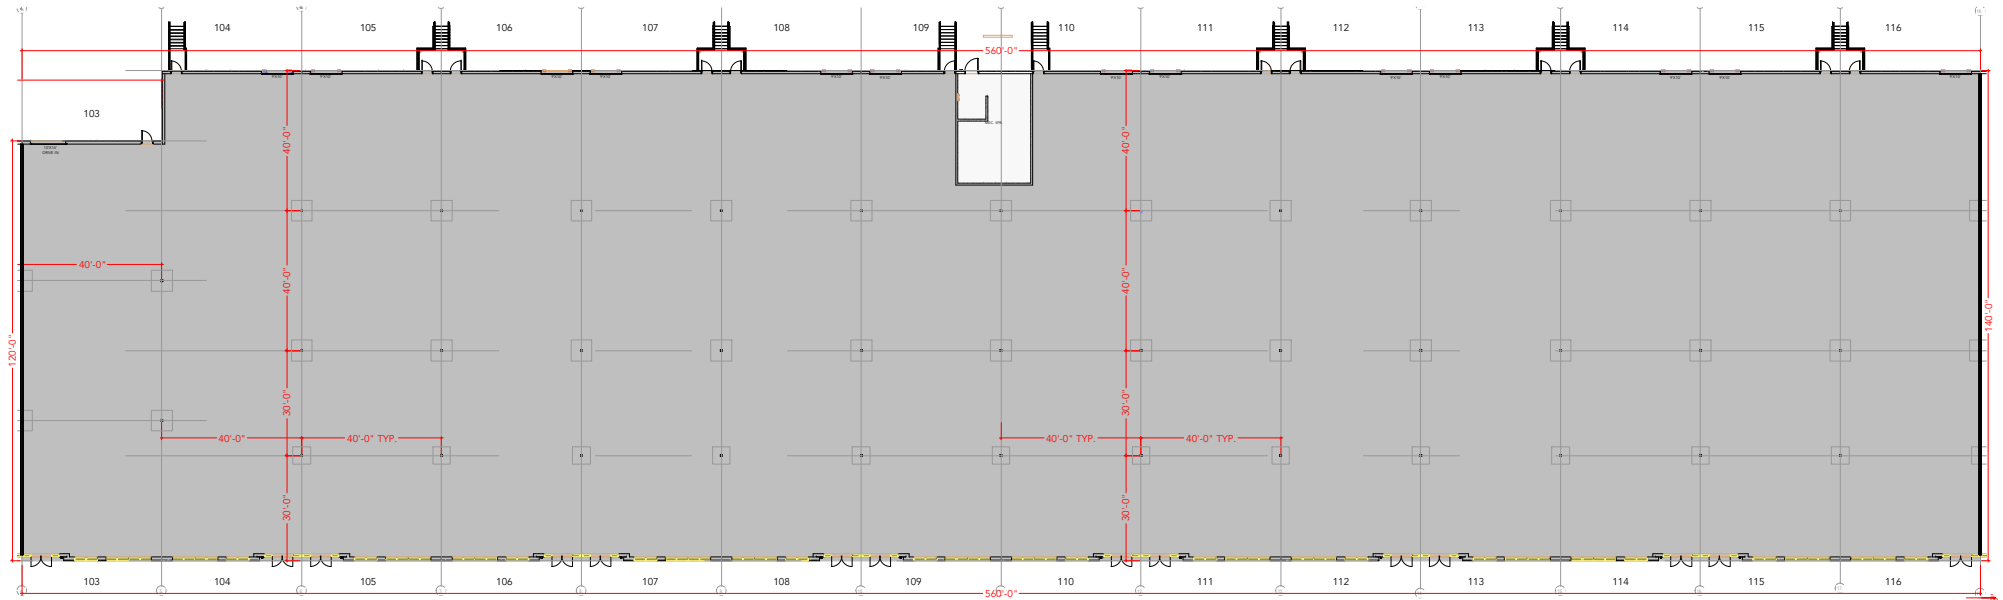

Floor Plan