



TOTAL SF AVAILABLE - 55,644 RSF

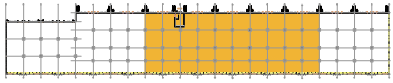

Key Plan

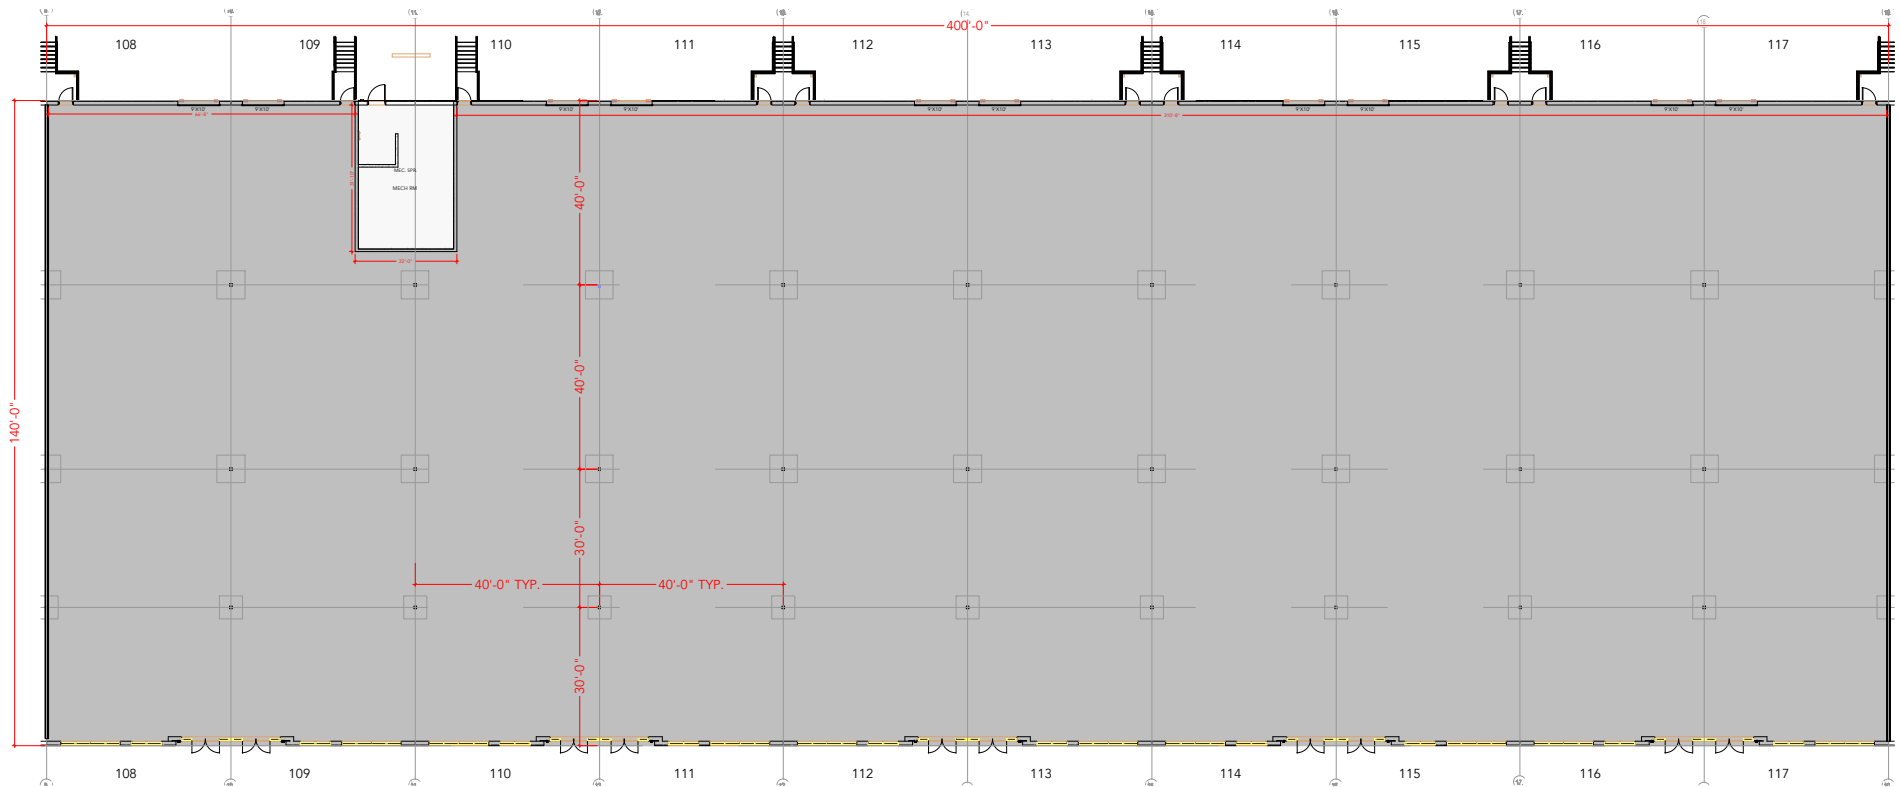

Floor Plan