



TOTAL SF AVAILABLE - 10,838 RSF

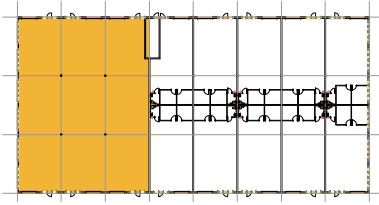

Key Plan

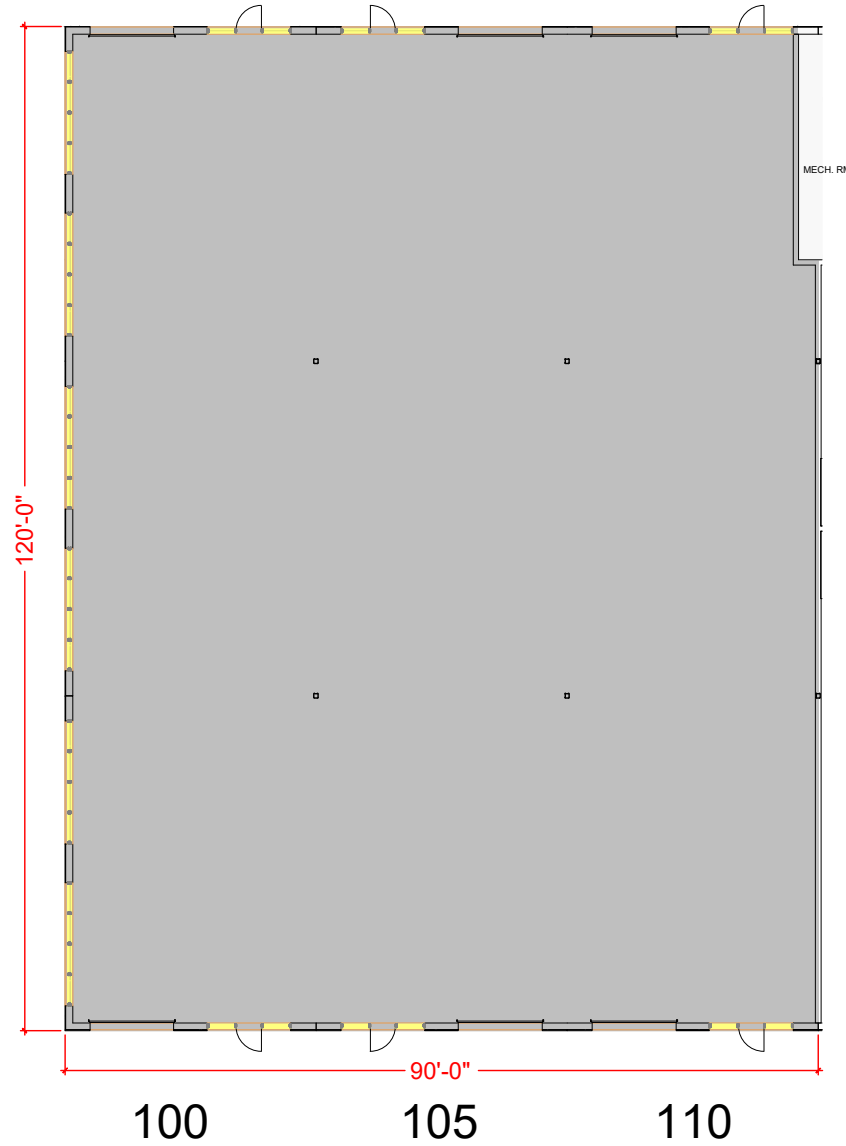

Floor Plan