


TOTAL SF AVAILABLE - 1,811 RSF


OFFICE - 315 RSF

WAREHOUSE - 1,496 RSF

[Click to access 3D model](#)

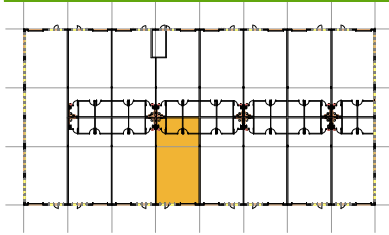

Key Plan

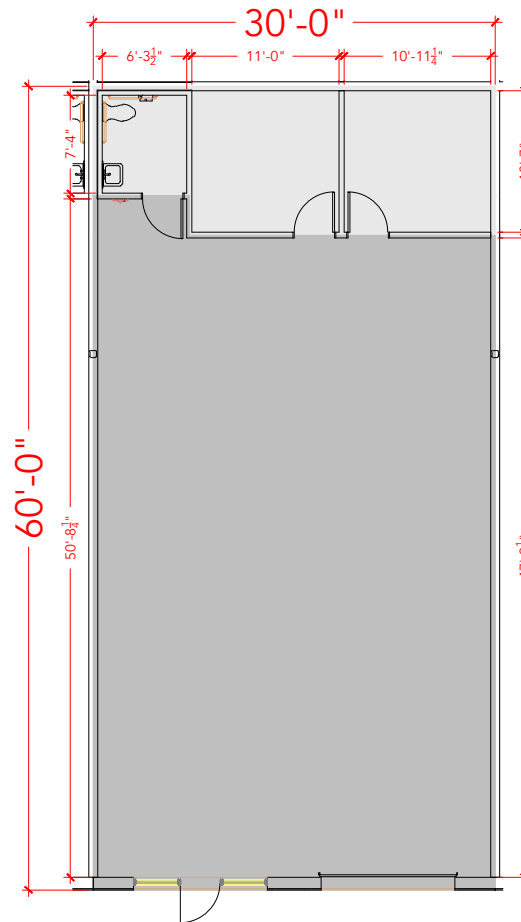

Floor Plan