


# 42 CROSSING

6140 NC HWY 42 GARNER, NC 27529  
SUITE 120


TOTAL SF AVAILABLE -1,811 RSF

OFFICE - 315 RSF

WAREHOUSE - 1,496 RSF

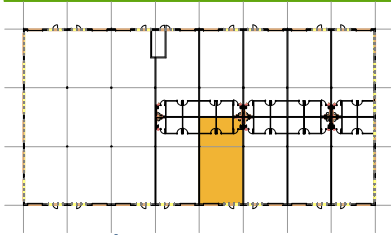

Key Plan

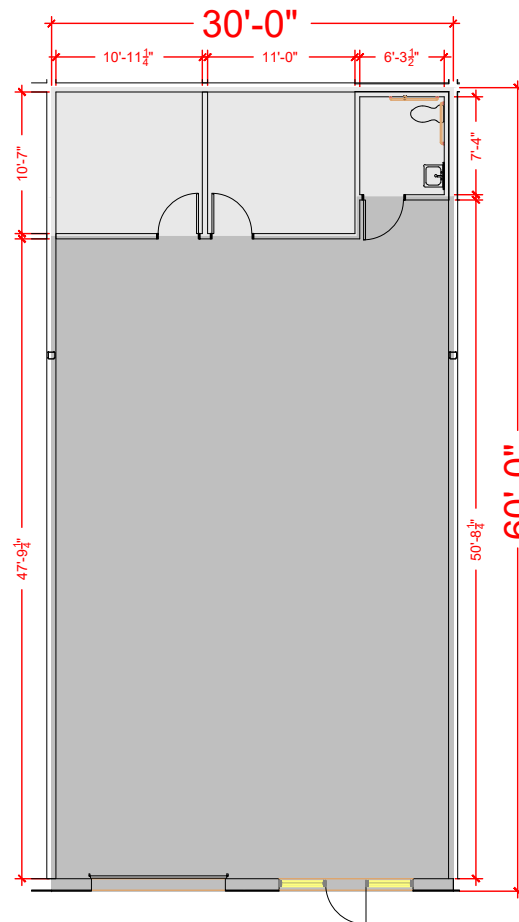

## Floor Plan