



TOTAL SF AVAILABLE -1,811 RSF

OFFICE - 315 RSF

WAREHOUSE - 1,496 RSF

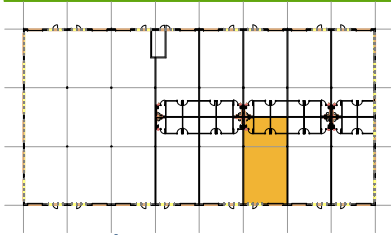

Key Plan

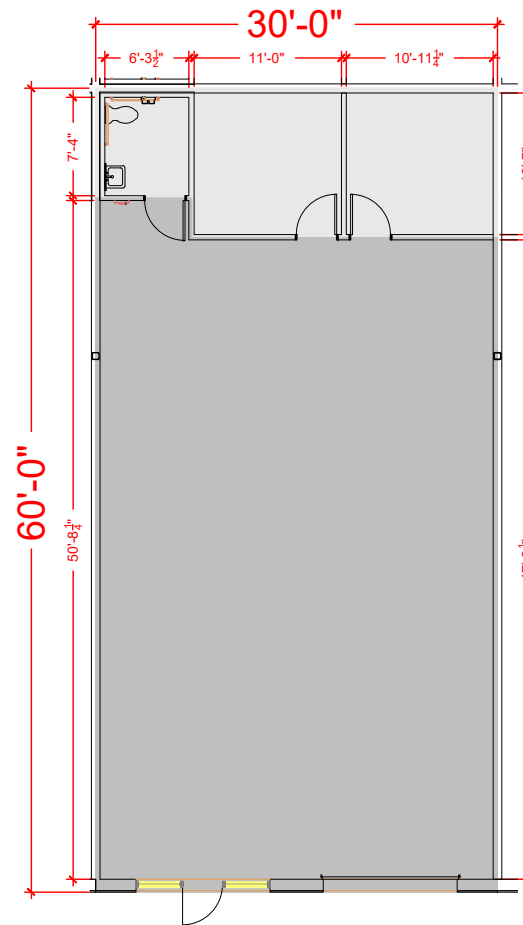

Floor Plan