



TOTAL SF AVAILABLE - 1,815 RSF

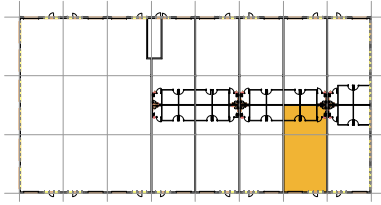

Key Plan

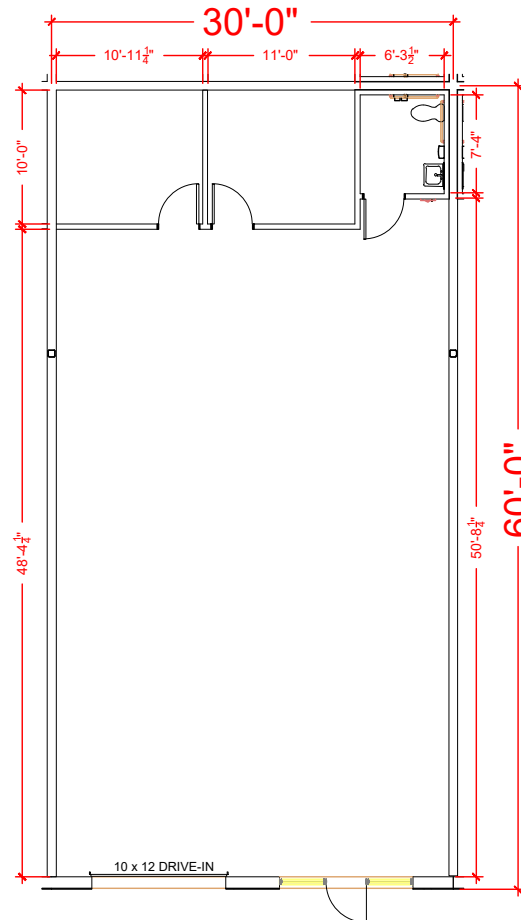

## Floor Plan