



TOTAL SF AVAILABLE - 1,815 RSF

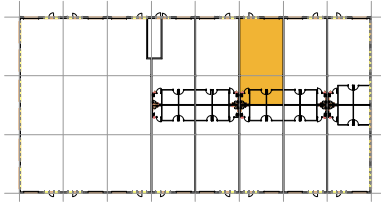

Key Plan

T

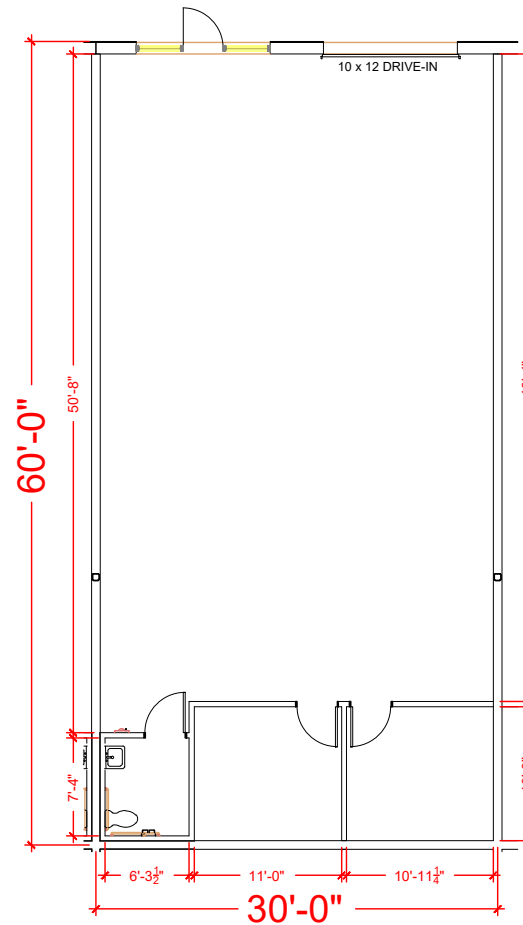

Floor Plan