


TOTAL SF AVAILABLE - 5,400 SF

OFFICE - 5,085 SF
WAREHOUSE - 315 SF

[Click to access 3D model](#)

8801	8802	8803	8804	8805	8806	8807	8808	8809	8810	8811	8812	8813	8814	8815	8816	8817	8818	8819	8820	8821	8822

Key Plan

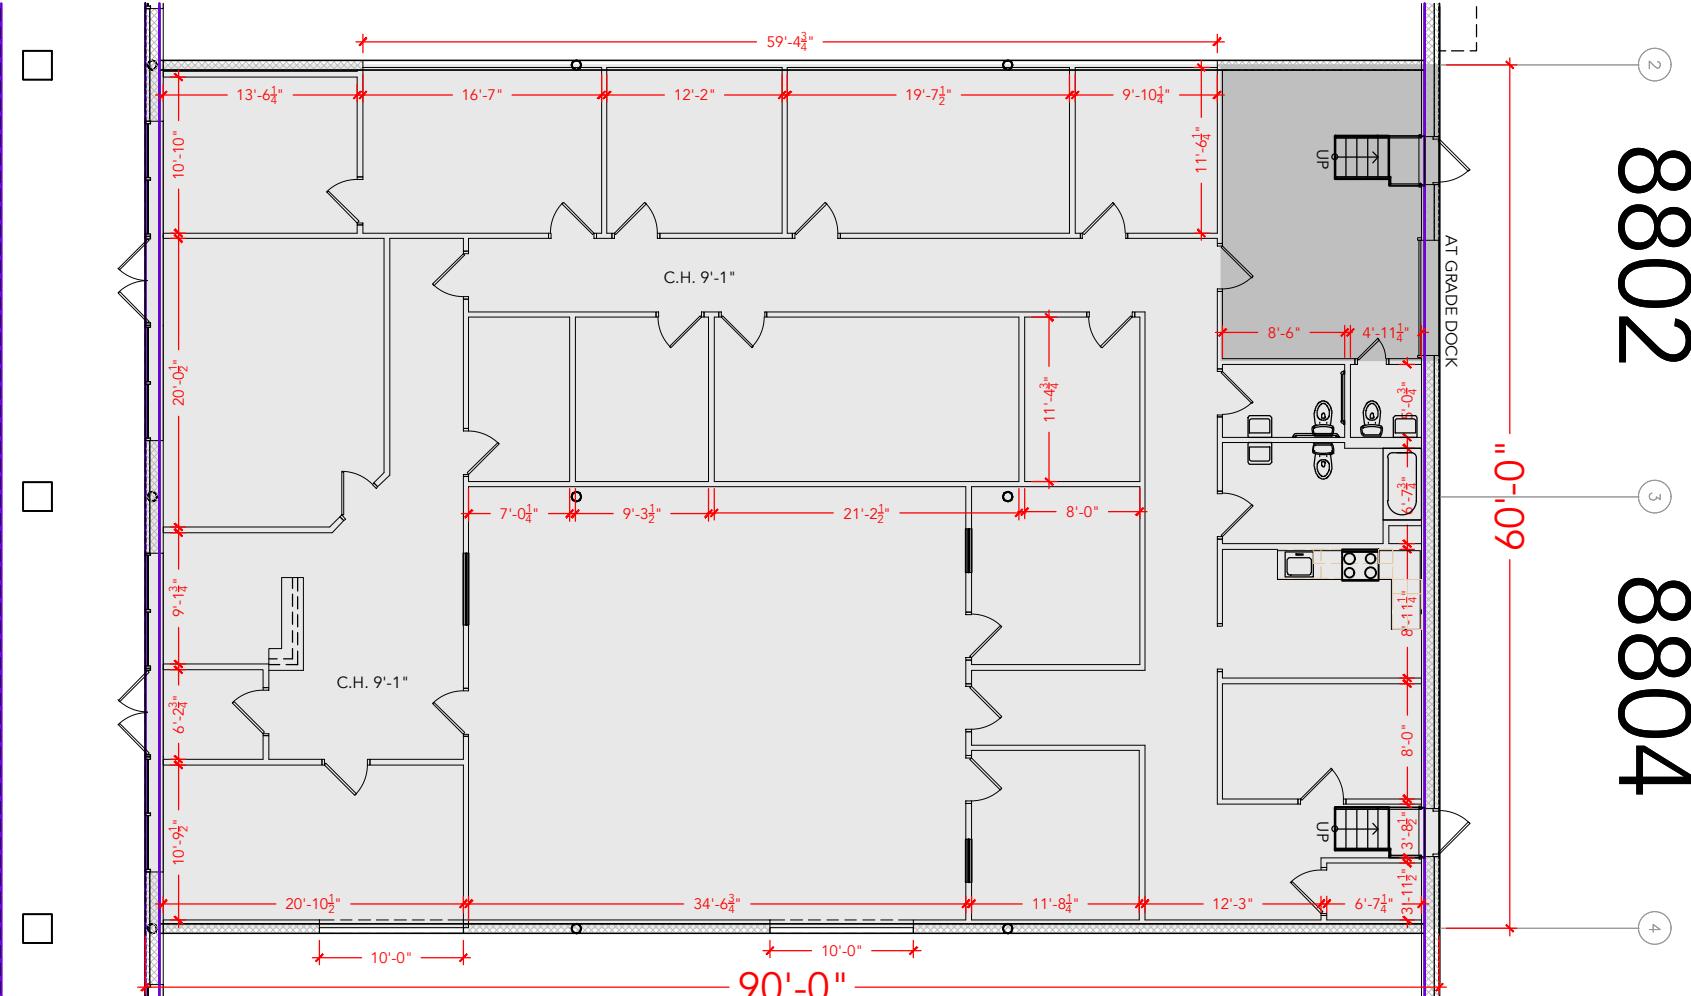

Floor Plan