



TOTAL SF AVAILABLE - 5,400 SF

OFFICE - 5,040 SF
WAREHOUSE - 360 SF

[Click to access 3D model](#)

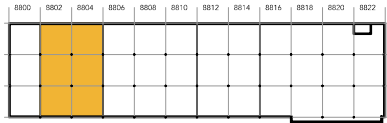

Key Plan

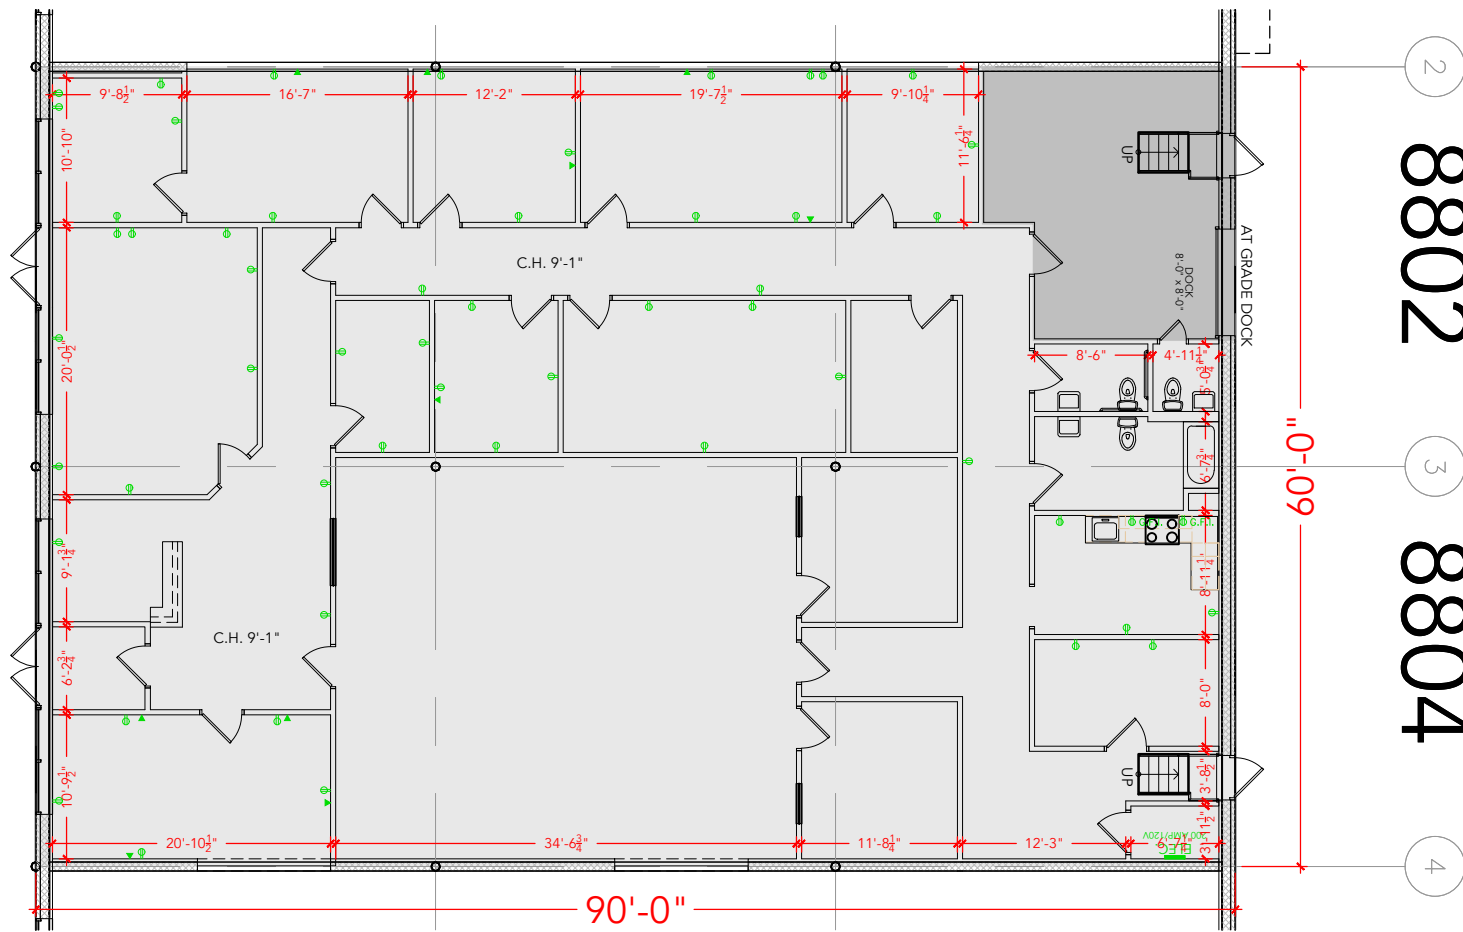

Floor Plan