



**TOTAL SF AVAILABLE - 11,085 SF**

OFFICE - 4,812 SF  
WAREHOUSE - 6,273 SF

[Click to access 3D model](#)

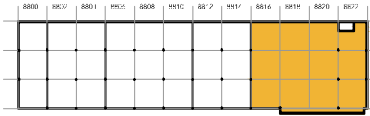

## Key Plan

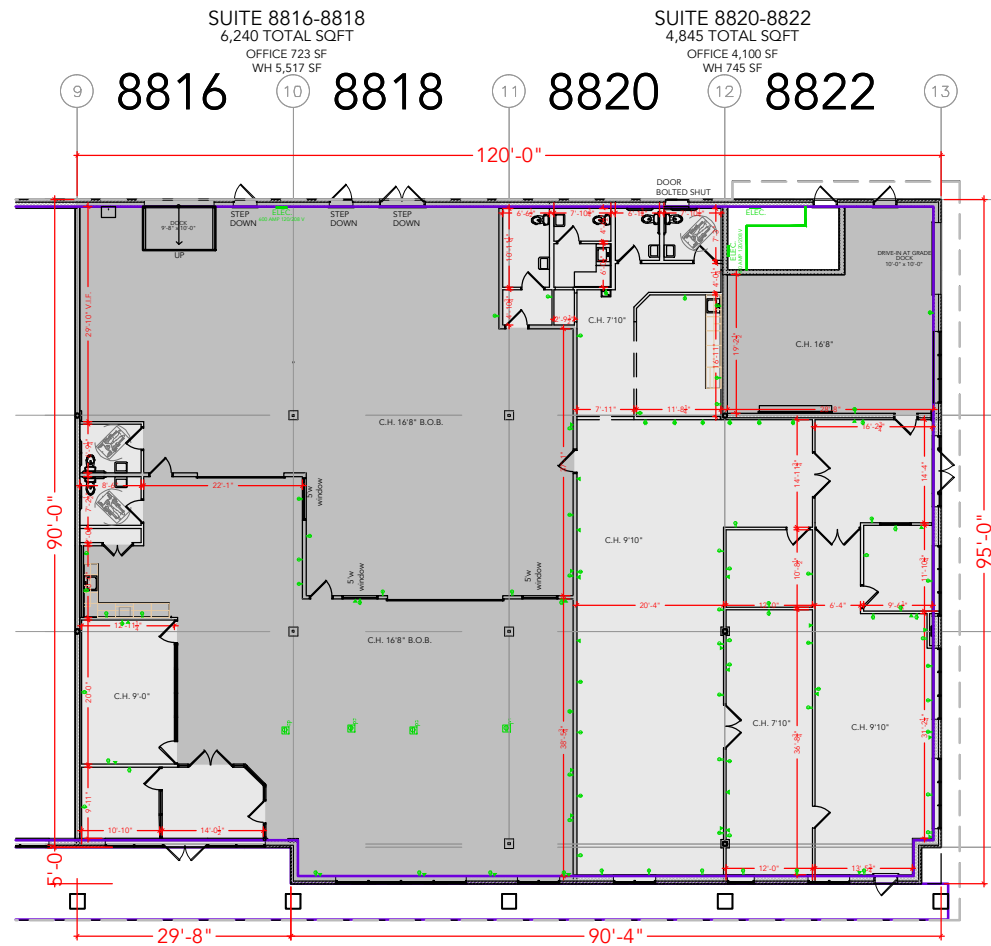

## Floor Plan