


TOTAL SF AVAILABLE - 5,400 SF

OFFICE - 0,000 SF
WAREHOUSE SF - 5,400 SF

[Click to access 3D model](#)

8838	8840	8842	8844	8846	8848	8850

Key Plan

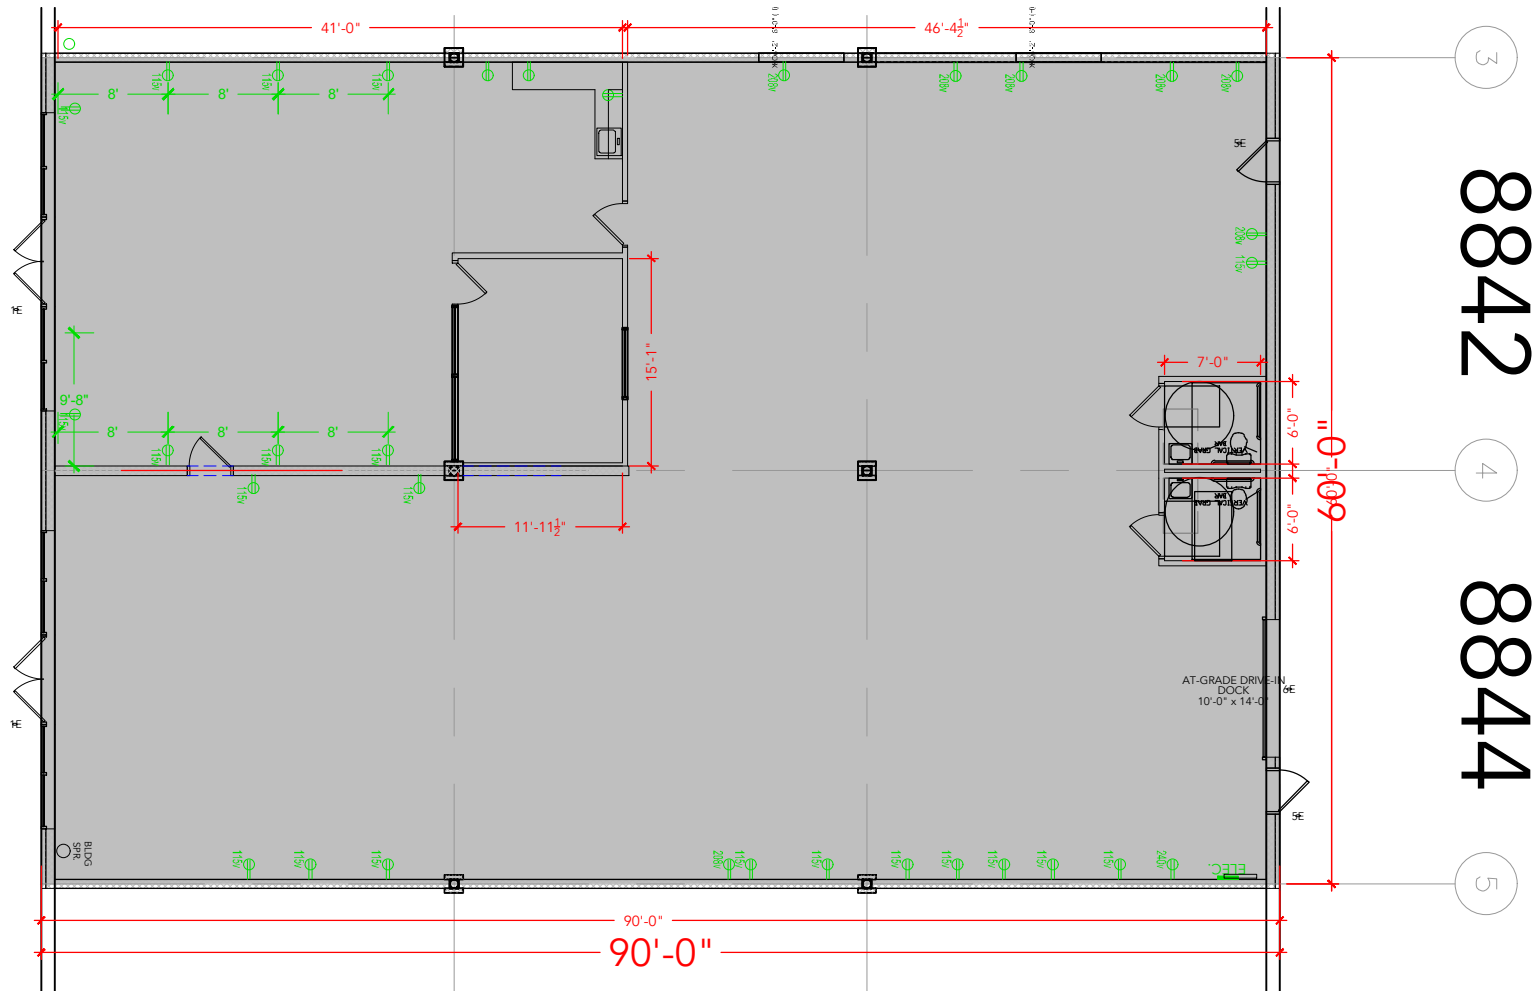

Floor Plan