


**TOTAL SF AVAILABLE - 5,400 SF**

OFFICE - 762 SF

WAREHOUSE - 4,638 SF

[Click to access 3D model](#)

Key Plan

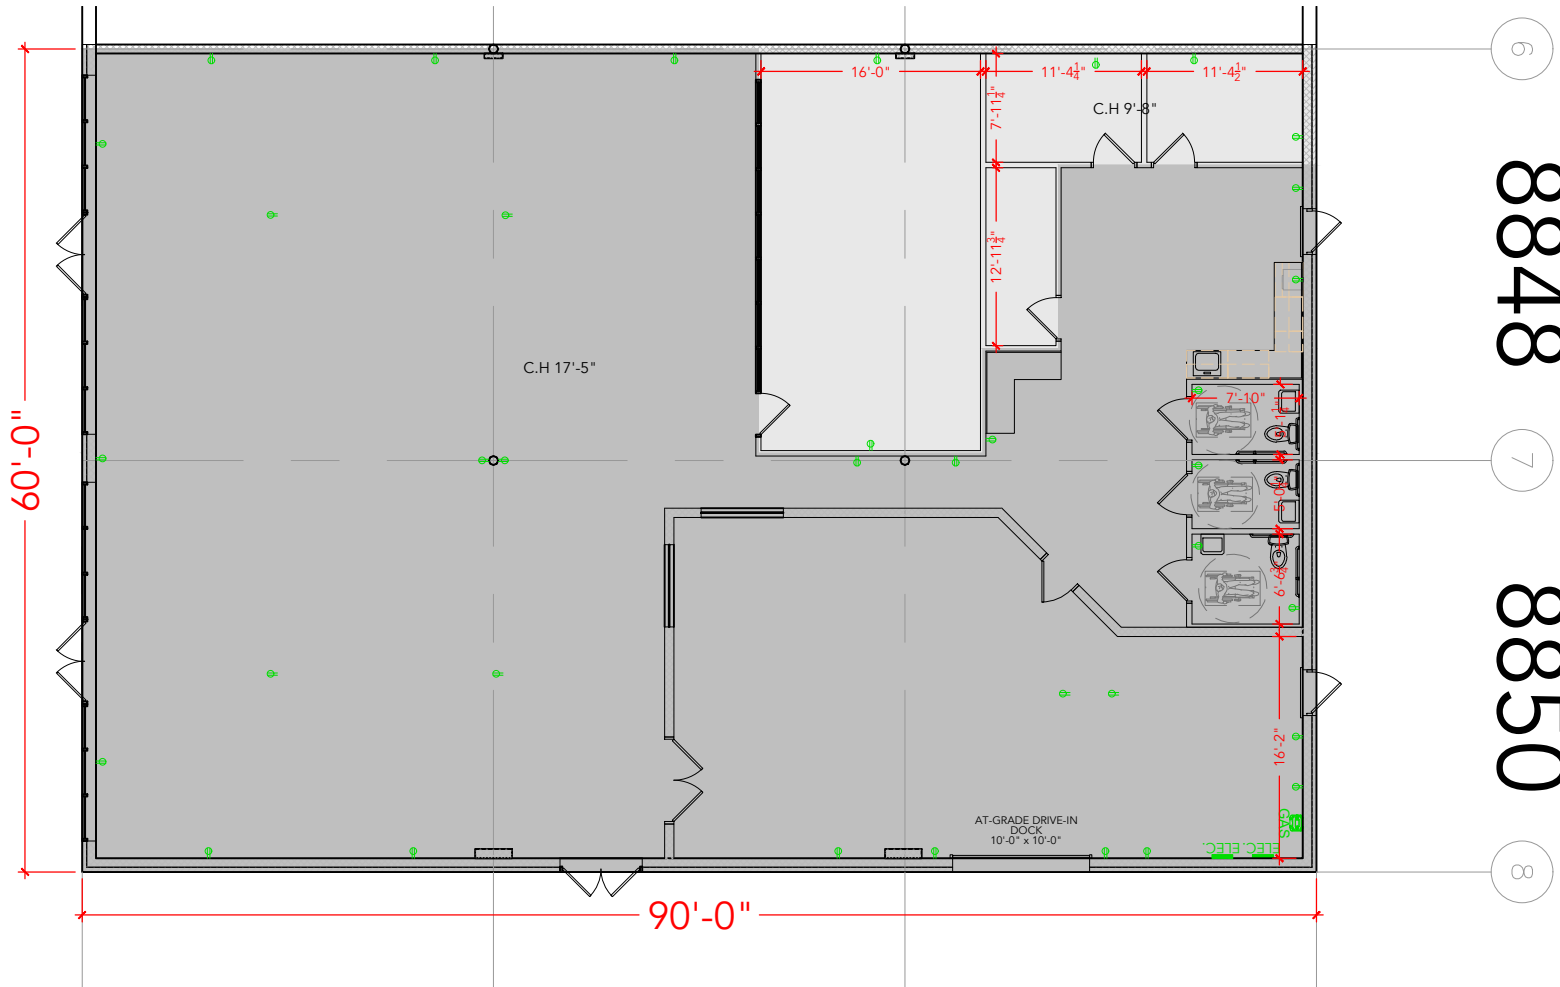

Floor Plan