


PULASKI RETAIL II

8675 PULASKI HIGHWAY BALTIMORE, MD 21237
SUITE 100-102-104


TOTAL SF AVAILABLE - 5,215 SF

OFFICE - 5,215 SF
WAREHOUSE - 0,000 SF

[Click to access 3D model](#)

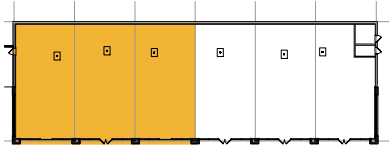

Key Plan

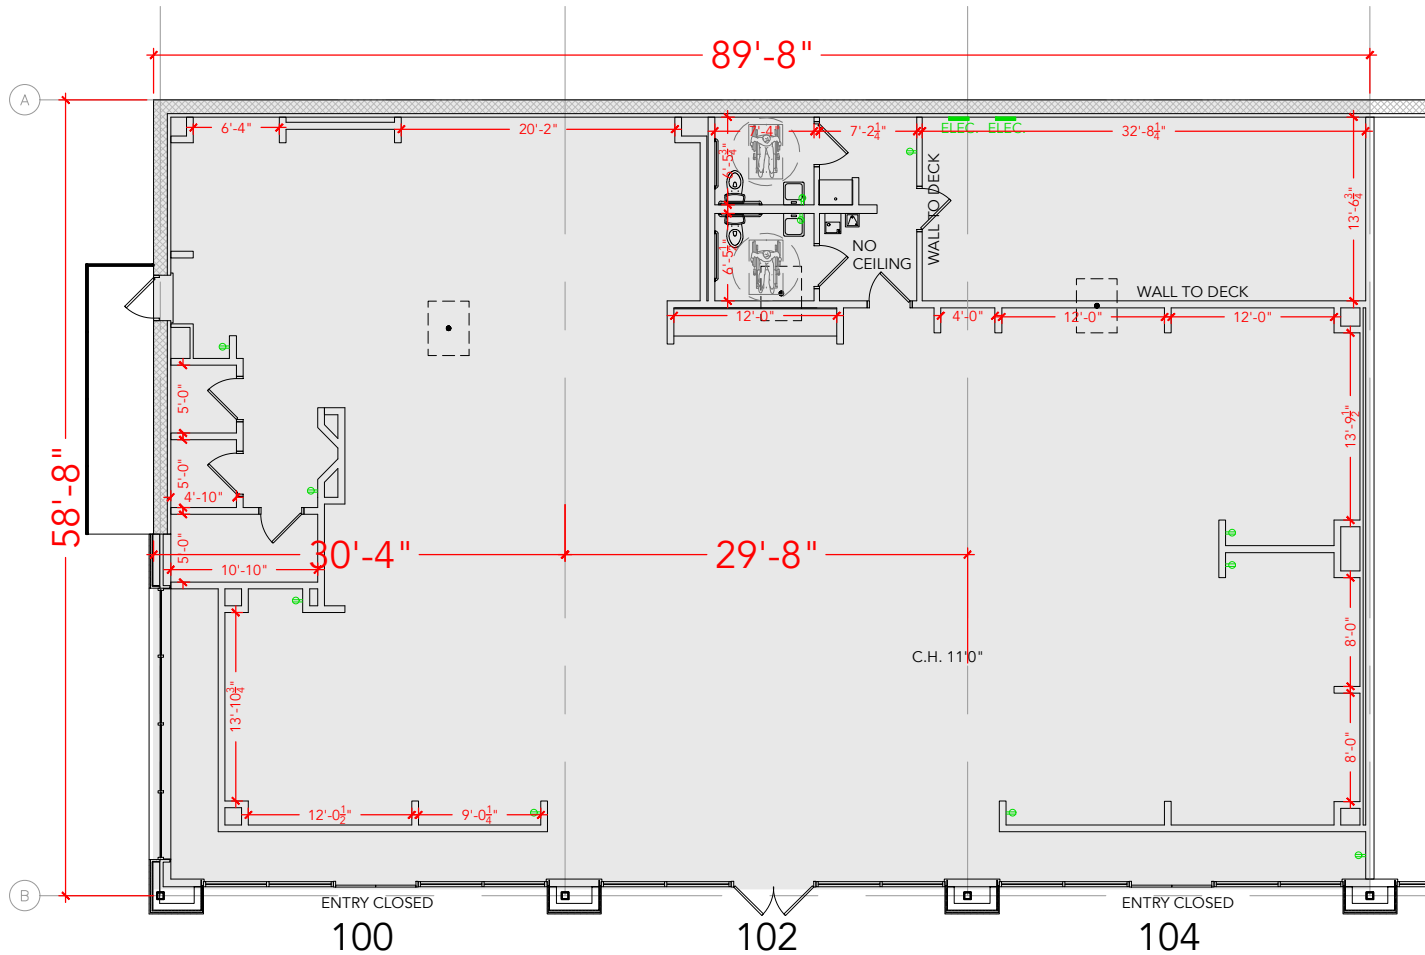

Floor Plan