


TOTAL SF AVAILABLE - 6,120 SF


OFFICE - 1,973 SF

WAREHOUSE - 4,147 SF

[Click to access 3D model](#)

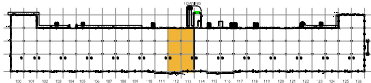

Key Plan

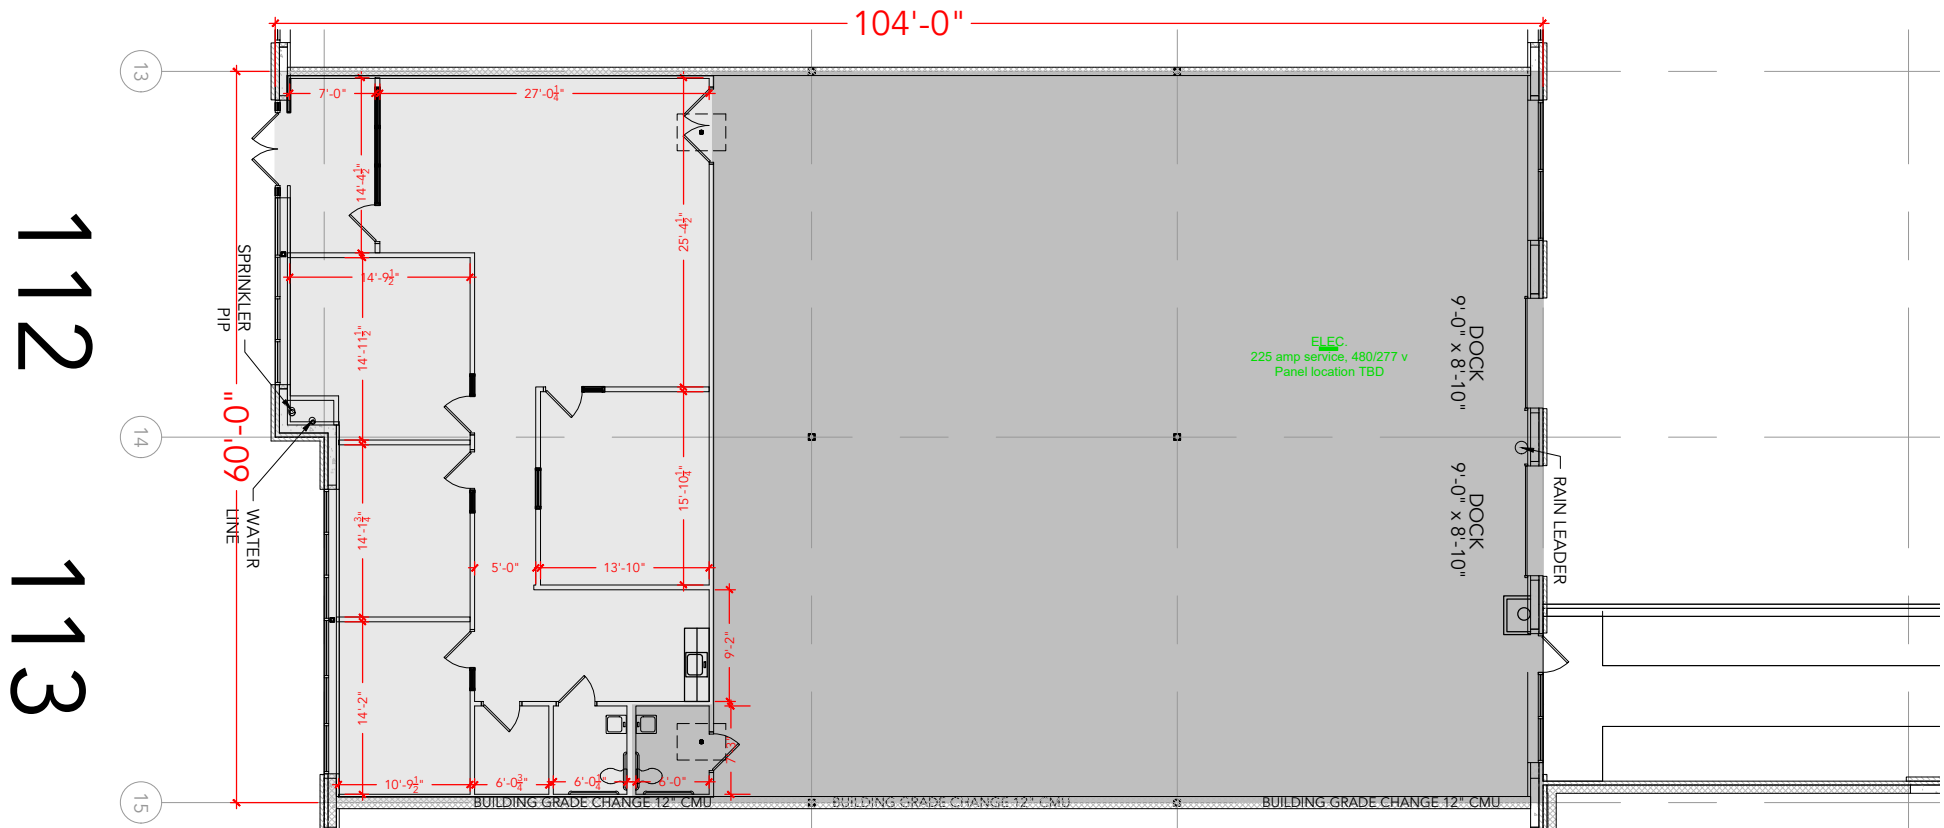

Floor Plan