


**TOTAL SF AVAILABLE - 9,240 SF**


**OFFICE - 4,764 SF**

**WAREHOUSE - 4,476 SF**

[Click to access 3D model](#)

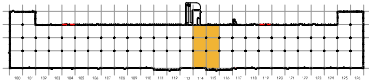

Key Plan

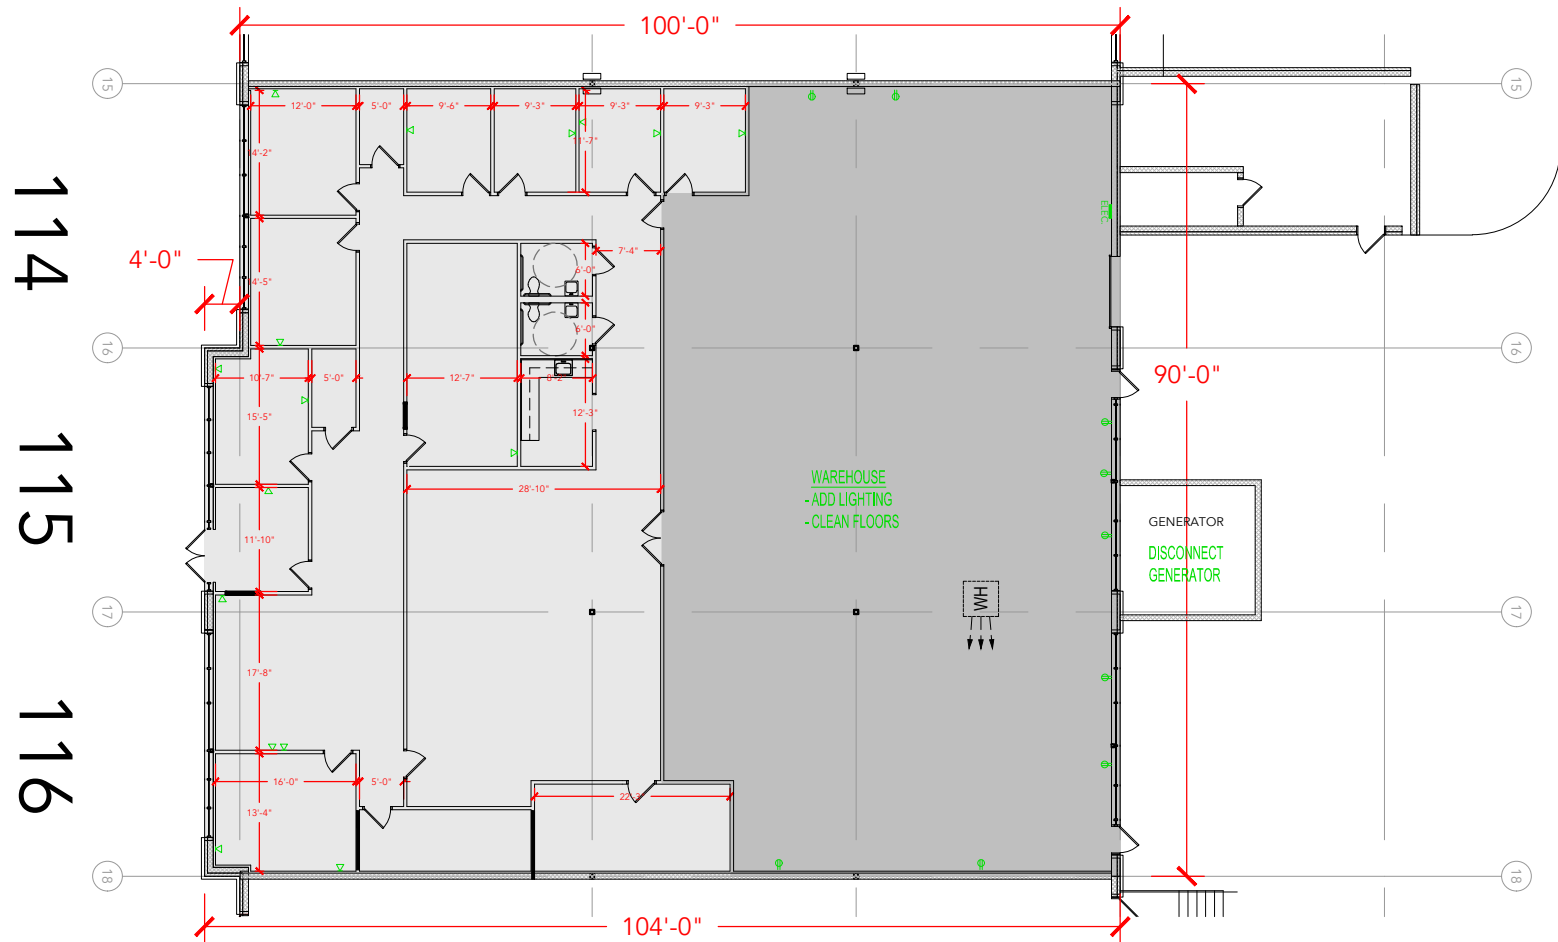

Floor Plan