


TOTAL SF AVAILABLE - 3,000 SF


OFFICE - 2,117 SF

WAREHOUSE - 833 SF

[Click to access 3D model](#)

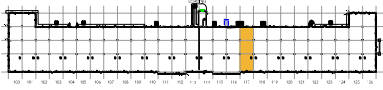

Key Plan

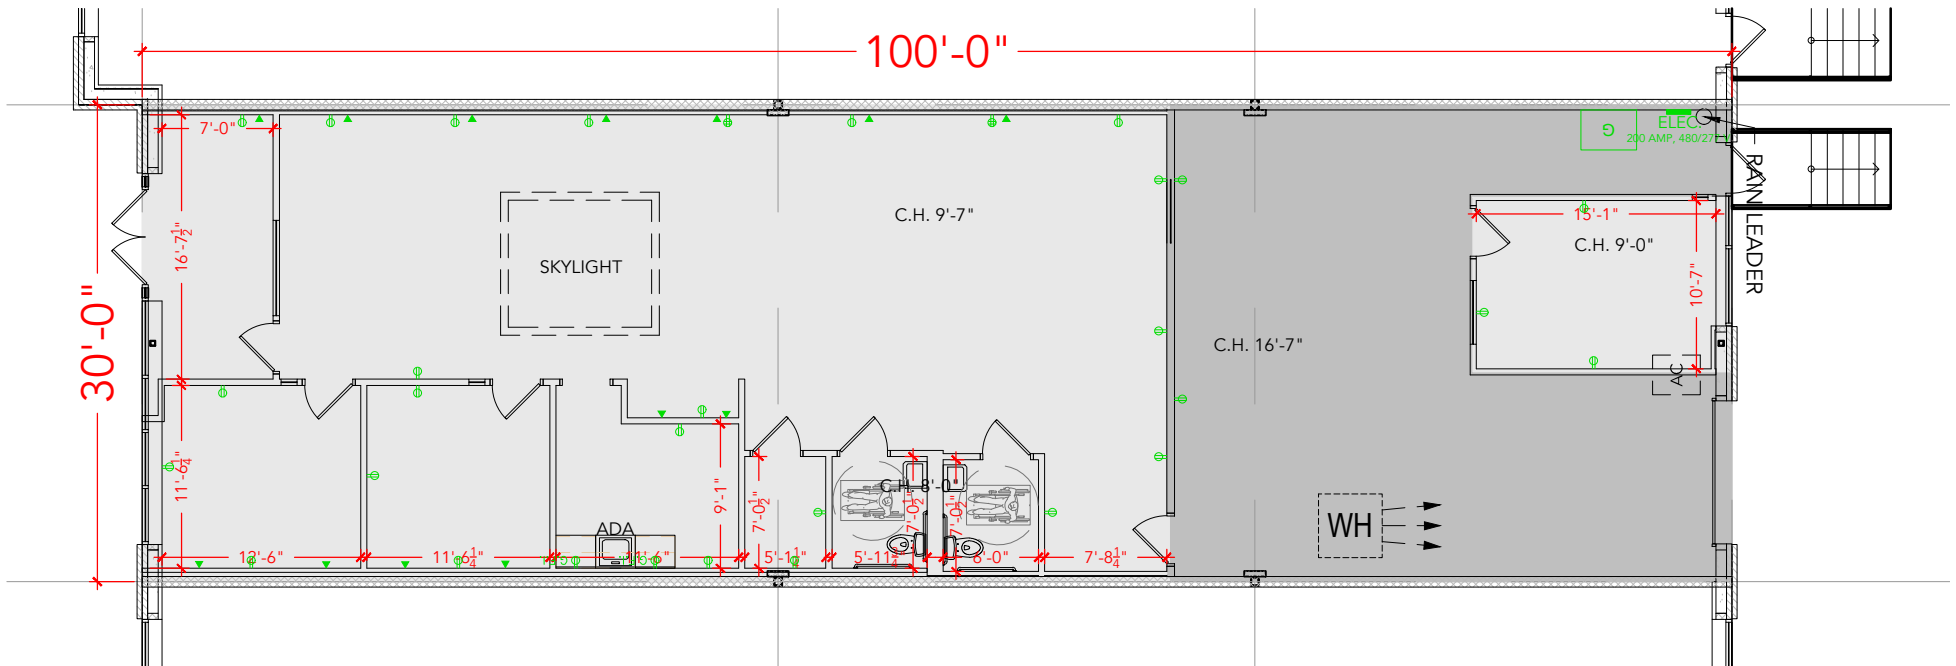

Floor Plan