


TOTAL SF AVAILABLE - 14,800 SF

OFFICE - 9,934 SF

WAREHOUSE - 4,866 SF

[Click to access 3D model](#)

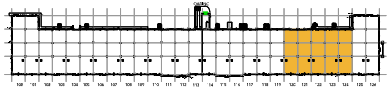

Key Plan



Floor Plan