


TOTAL SF AVAILABLE - 14,800 SF


OFFICE - 10,023 SF

WAREHOUSE - 4,777 SF

[Click to access 3D model](#)

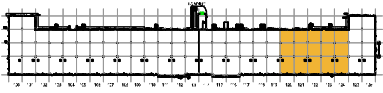

Key Plan

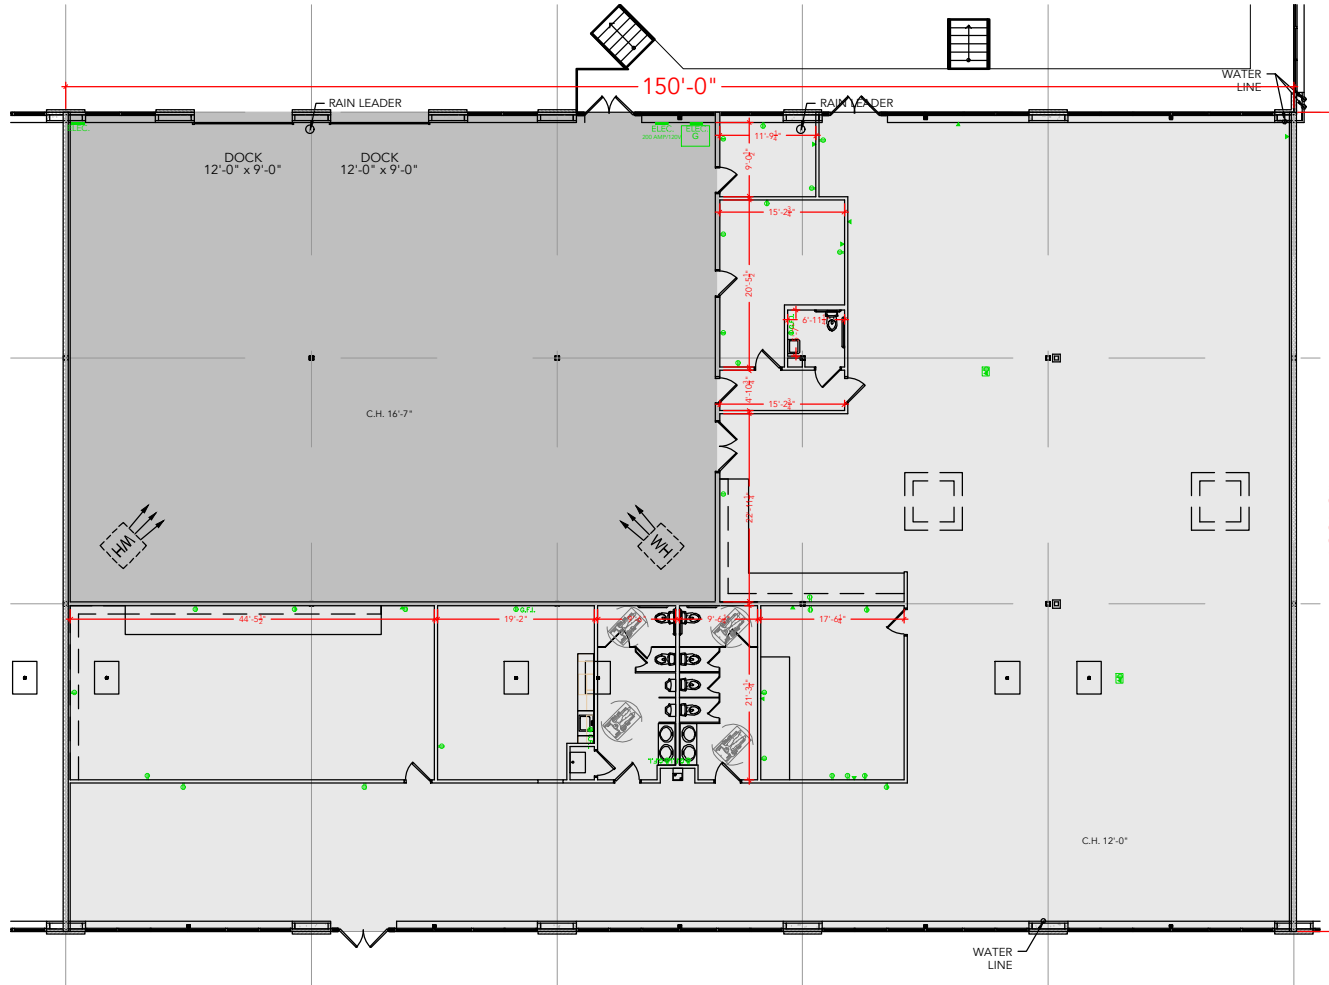

Floor Plan