



TOTAL SF AVAILABLE -15,000 SF

OFFICE - 5,915 SF

WAREHOUSE - 9,086 SF

[Click to access CADD file](#)

Key Plan

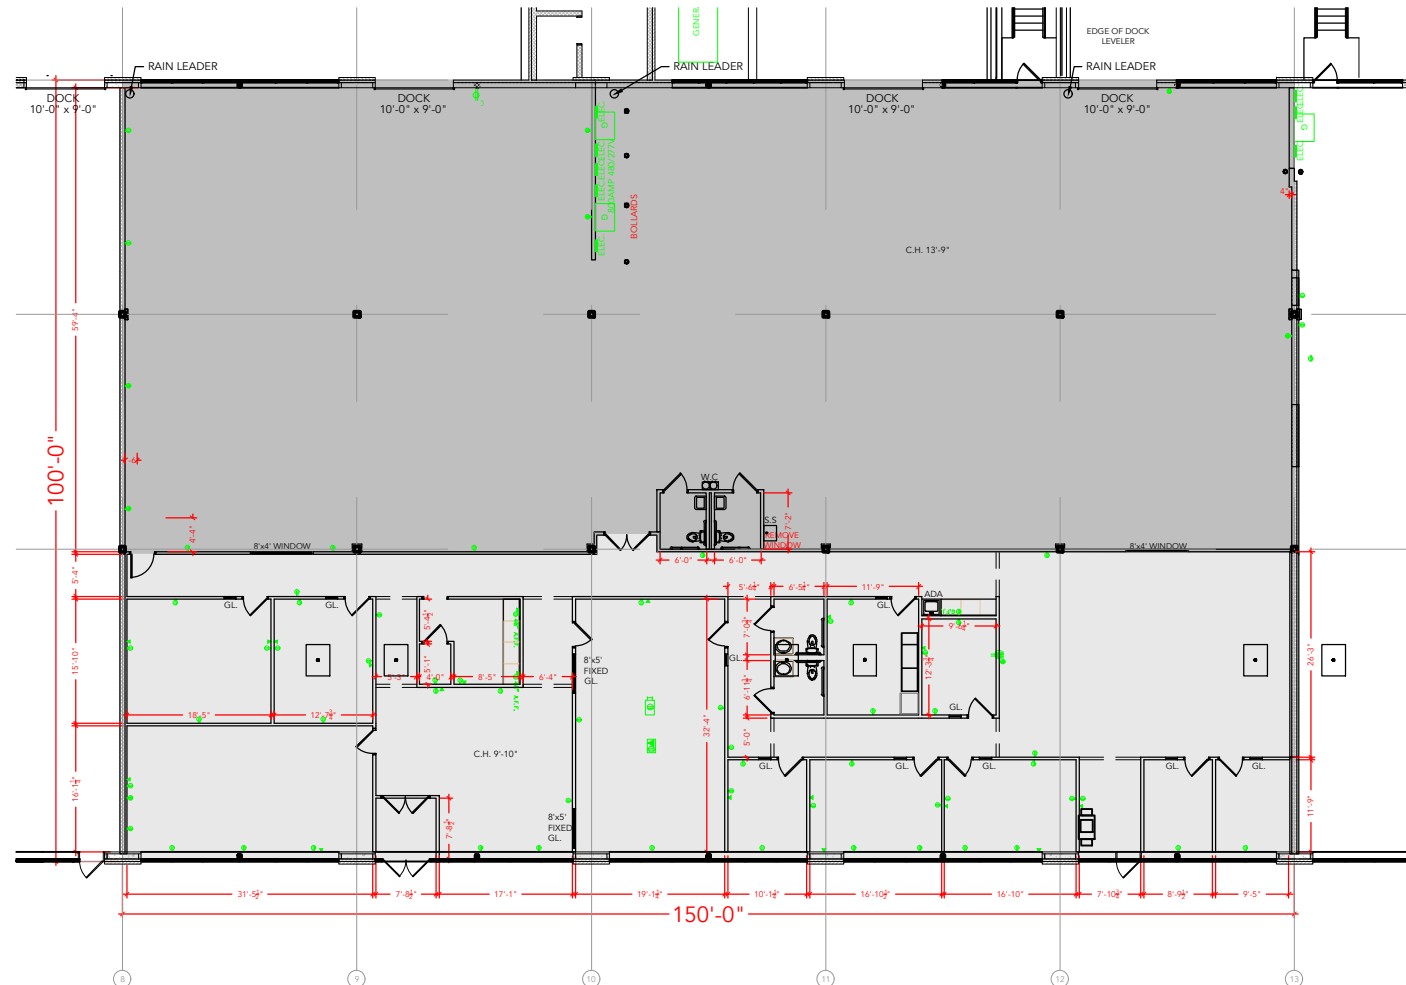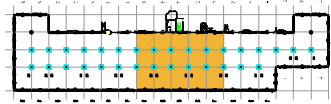

Floor Plan