


Key Plan

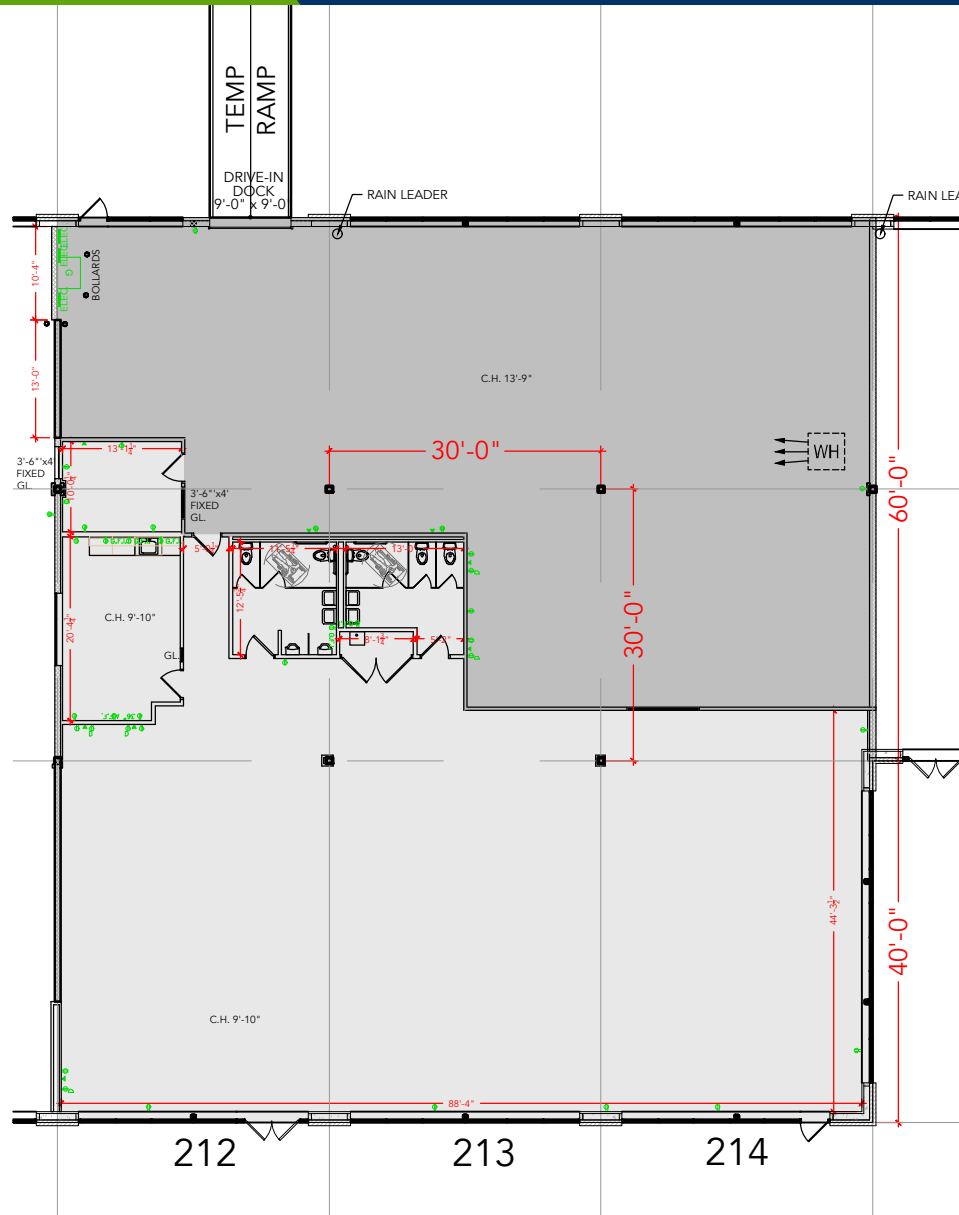

**TOTAL SF AVAILABLE -9,000 SF**

OFFICE - 5,131 SF

WAREHOUSE - 3,869 SF

[Click to access 3D model](#)

## Floor Plan