


TOTAL SF AVAILABLE -7,200 SF


OFFICE - 6,495 SF

WAREHOUSE - 705 SF

[Click to access CADD file](#)

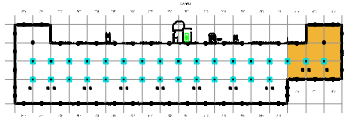

Key Plan

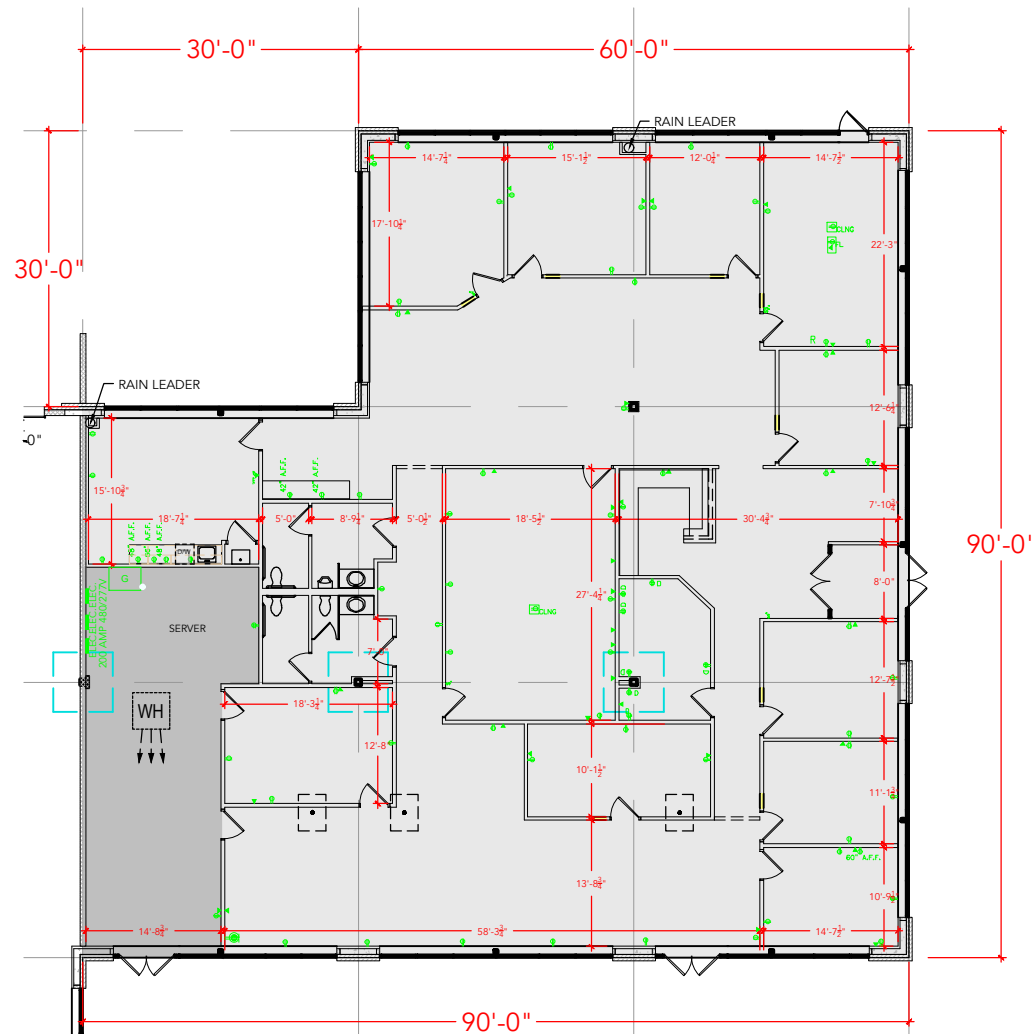

Floor Plan