

**TOTAL SF AVAILABLE - 10,661 RSF**

**OFFICE - 0,000 SF**


**WAREHOUSE - 10,661 SF**

\* INCLUDES % OF METER ROOM

[Click to access 3D model](#)



Key Plan

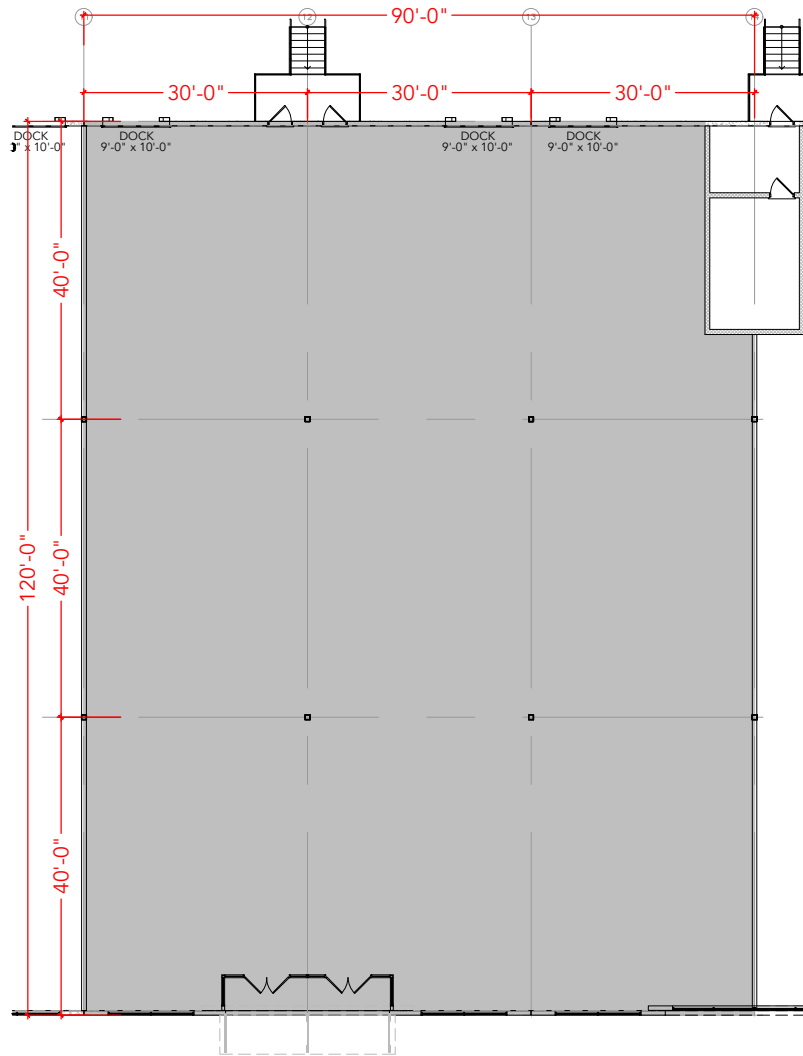

Floor Plan

140      144      148