


TOTAL SF AVAILABLE -7,233 RSF

OFFICE - 3,078 RSF


WAREHOUSE - 4,155 RSF

* INCLUDES % OF METER ROOM

[Click to access CADD file](#)

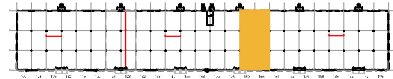

Key Plan

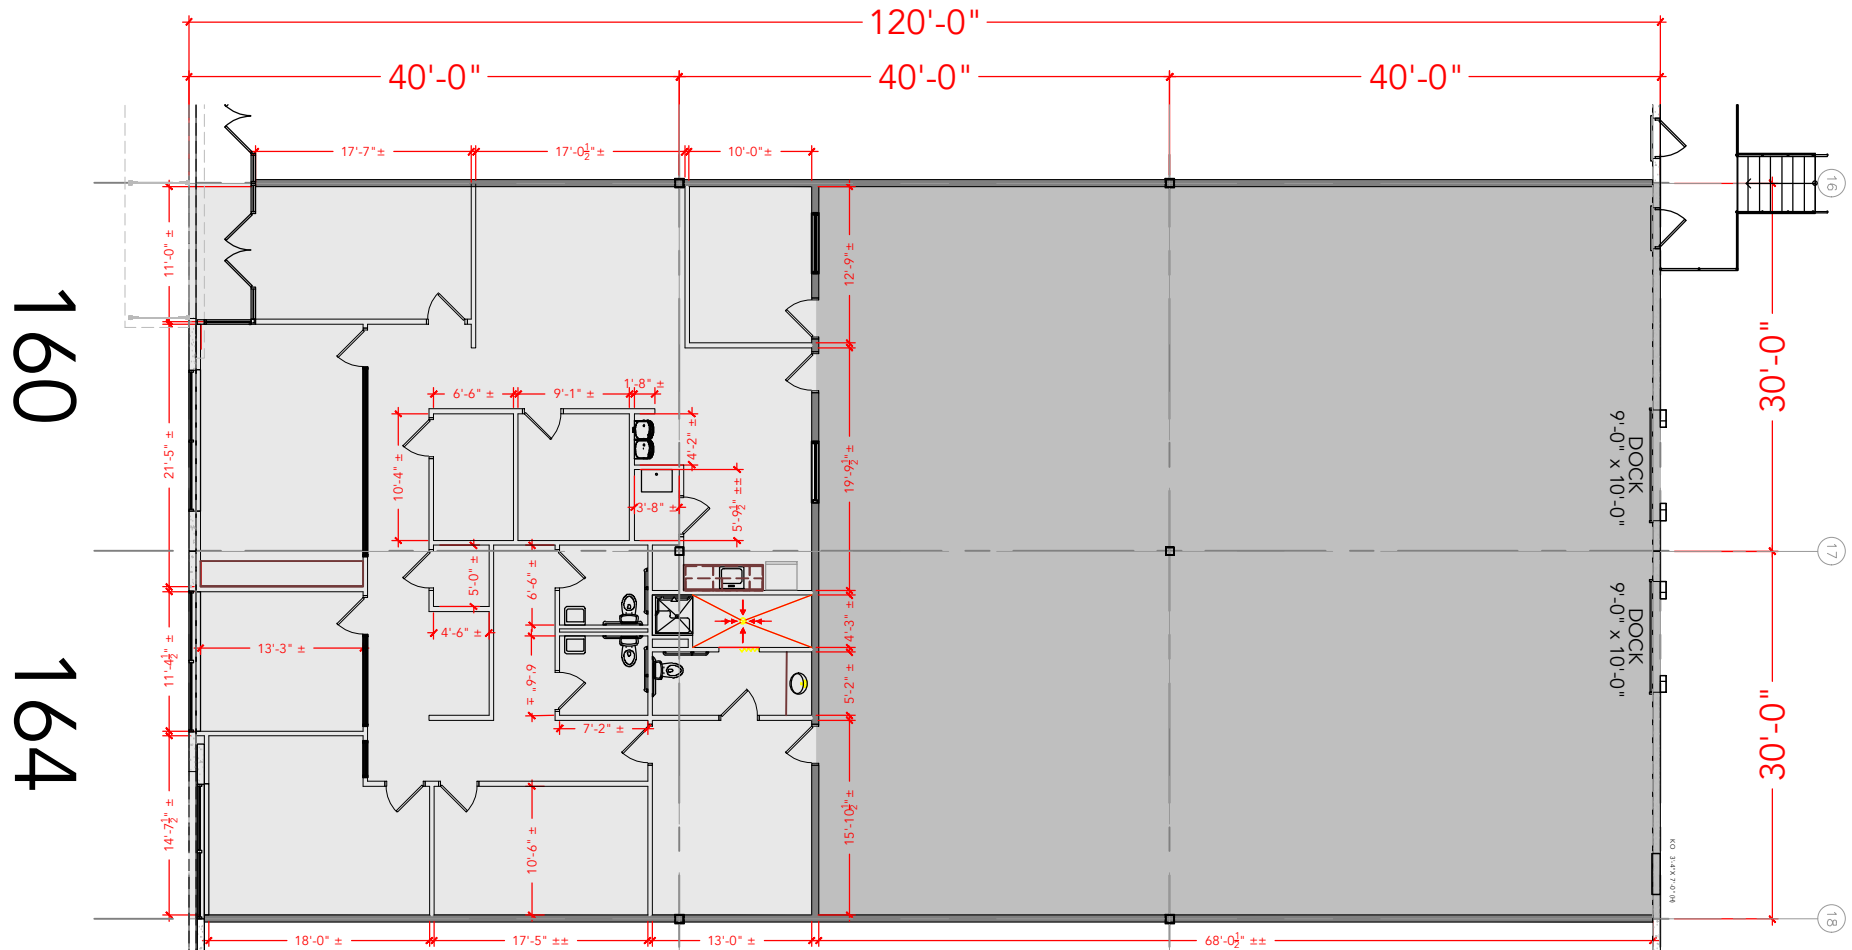

Floor Plan