


TOTAL SF AVAILABLE - 18,979 RSF


OFFICE - 0,000 SF

WAREHOUSE - 18,979 RSF

* INCLUDES % OF METER ROOM
[Click to access 3D model](#)

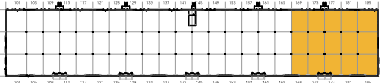

Key Plan

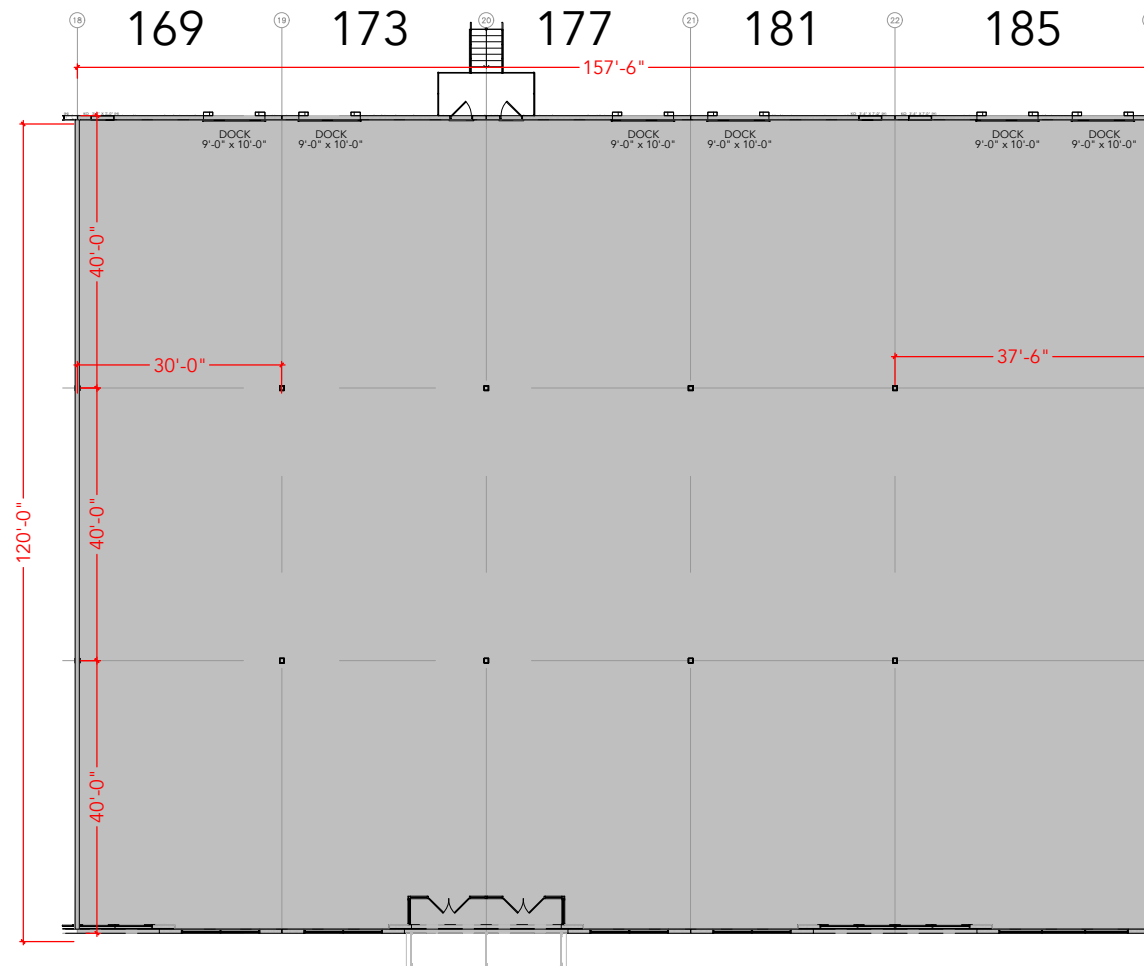

Floor Plan