


Key Plan

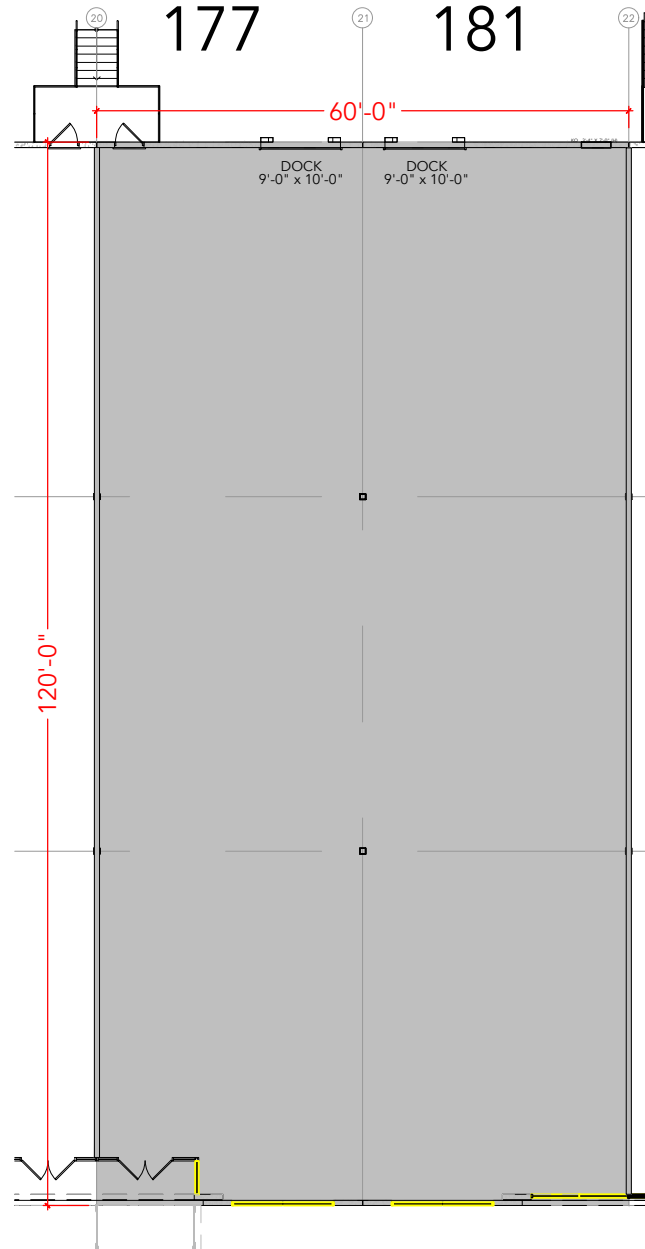

TOTAL SF AVAILABLE - 7,230 RSF

OFFICE - 0,000 RSF

WAREHOUSE - 7,230 RSF

* INCLUDES % OF METER ROOM

Floor Plan