


TOTAL SF AVAILABLE - 11,749 RSF


OFFICE - 0,000 RSF

WAREHOUSE - 11,749 RSF

[Click to access 3D model](#)

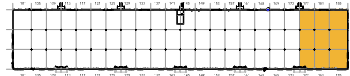

Key Plan

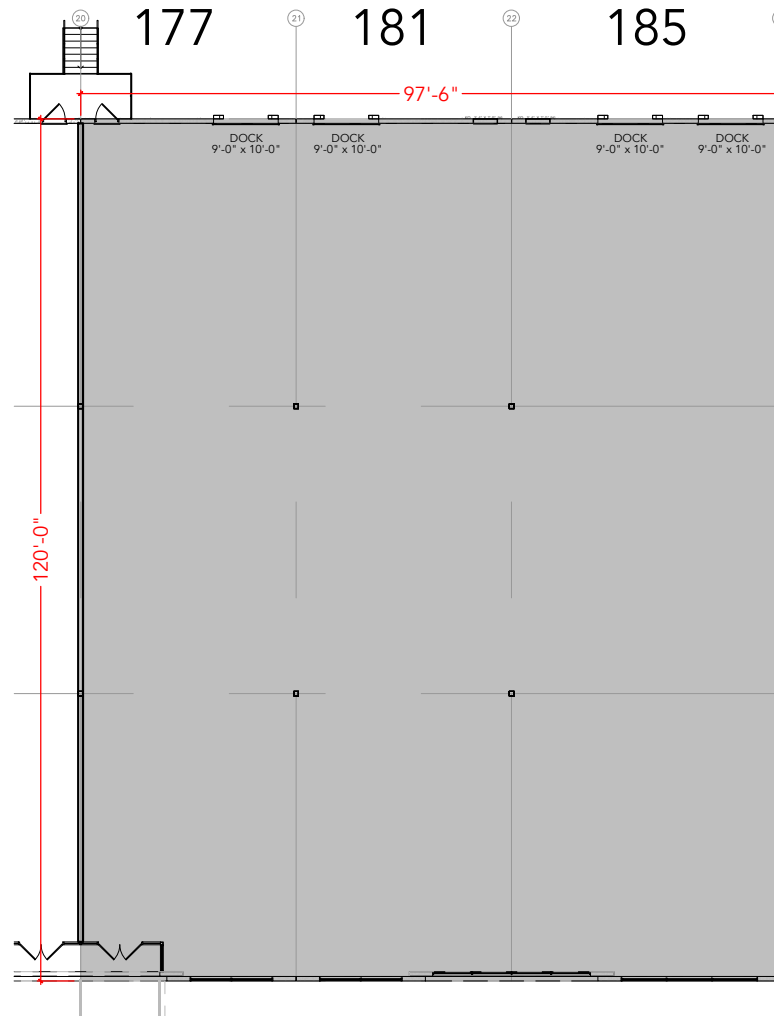

Floor Plan