


TOTAL SF AVAILABLE -61,200 RSF

OFFICE - 0,000 RSF


WAREHOUSE - 61,200 RSF

* INCLUDES % OF METER ROOM

[Click to access CADD file](#)

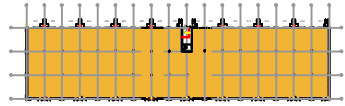

Key Plan

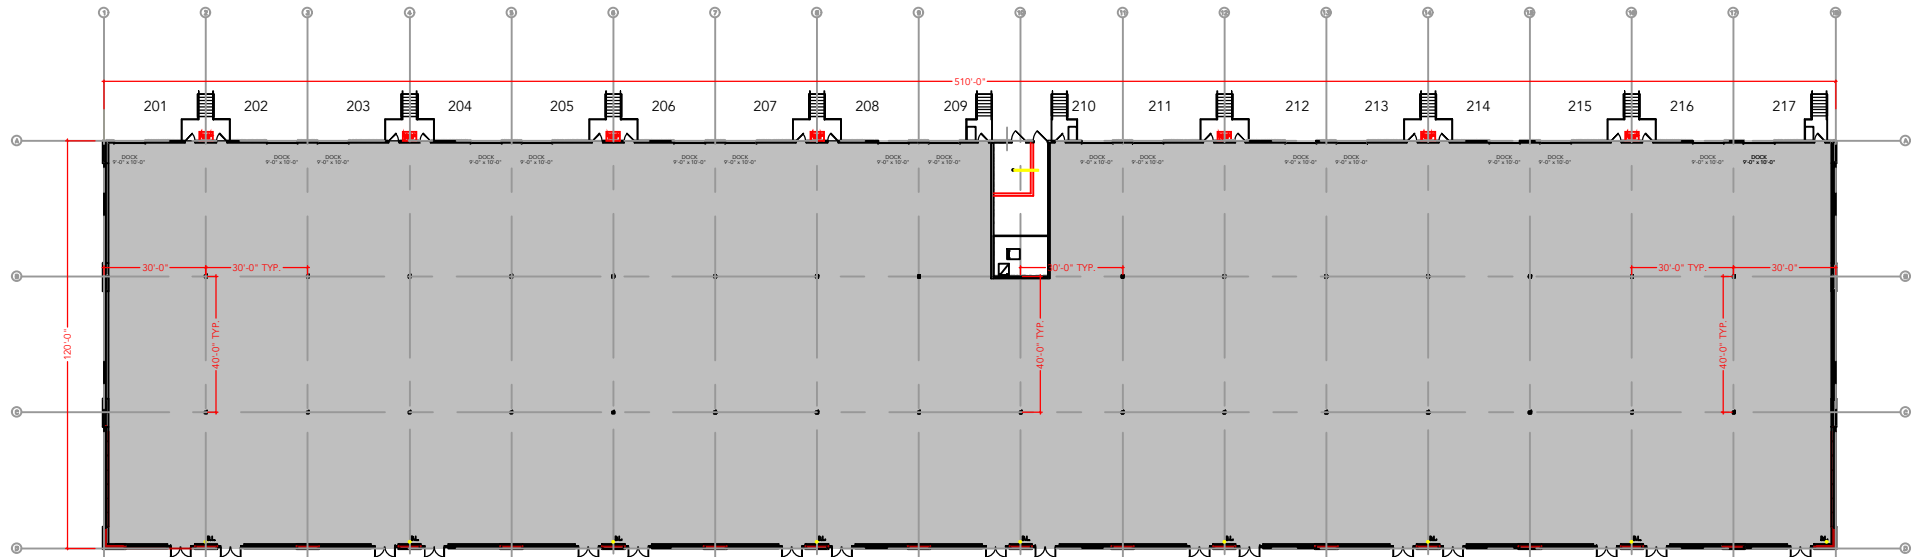

Floor Plan