


RESEARCH PARK - BUILDING 1

5521 RESEARCH PARK DR. CATONSVILLE, MD 21228

Suite 100-190

20,884 TOTAL SF (9%)

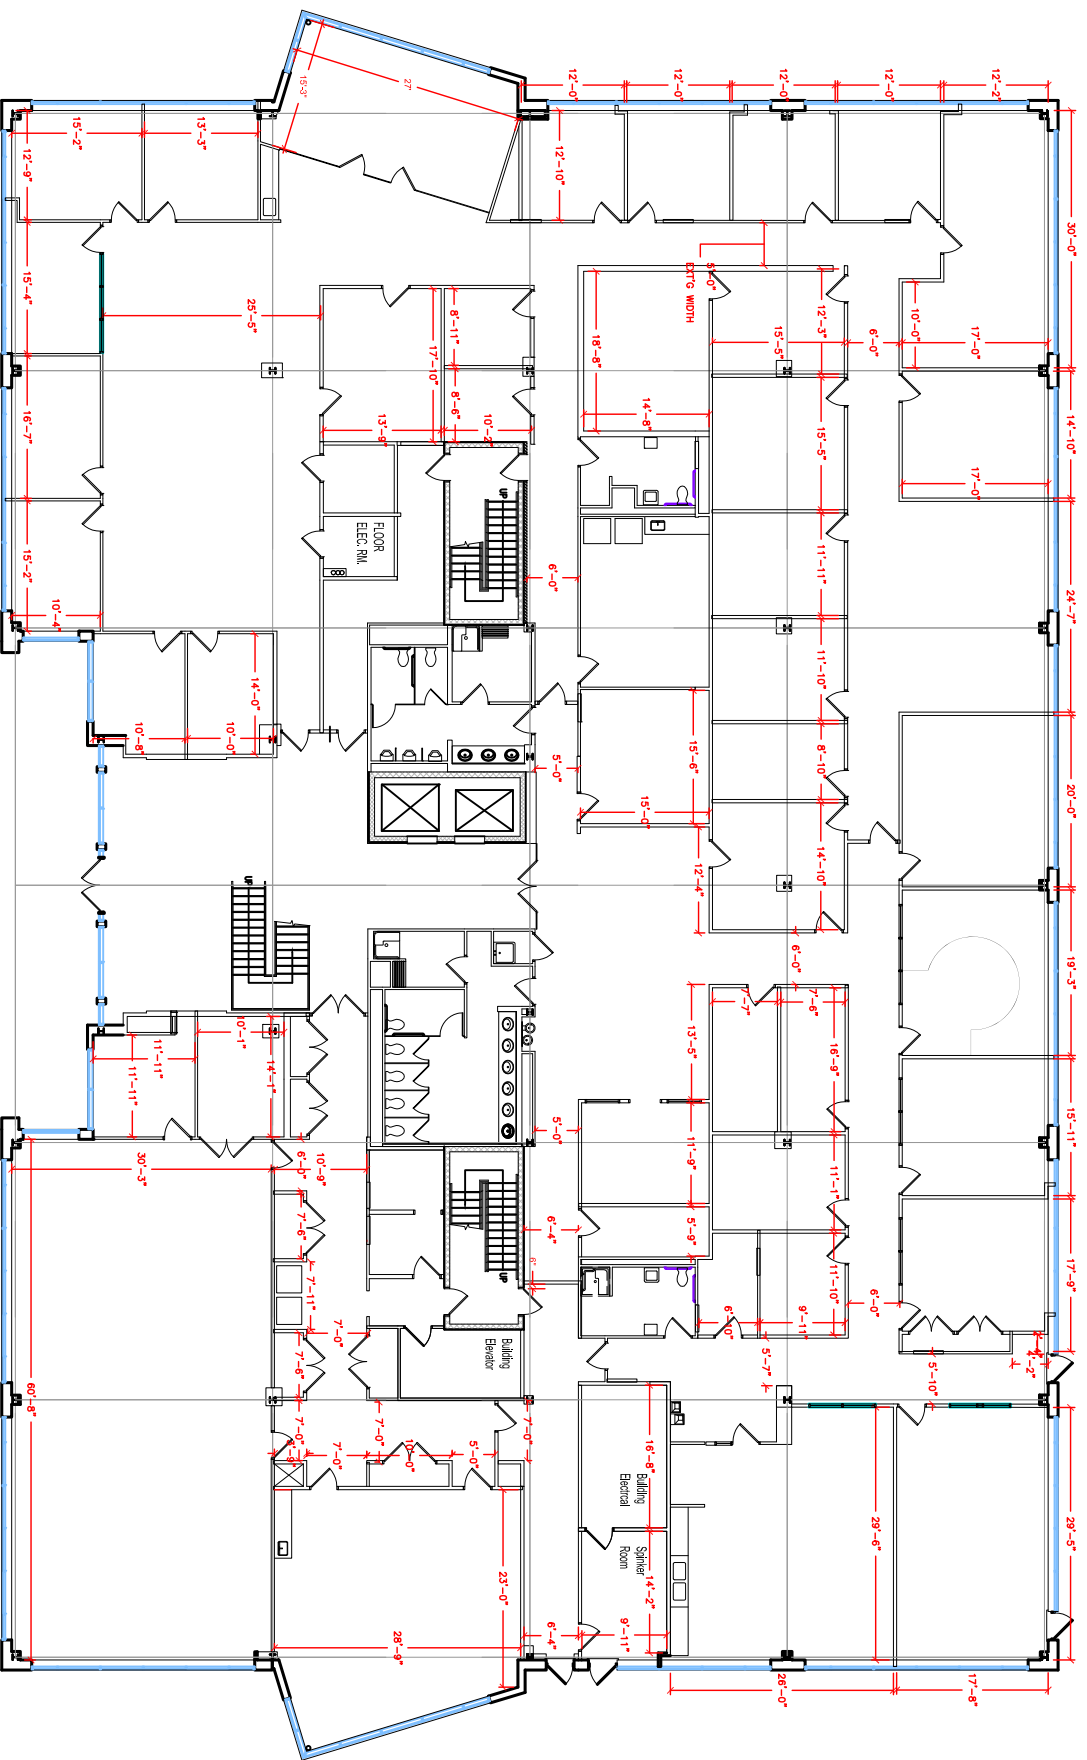

Floor Plan

PLAN NOT TO SCALE - THIS IS NOT A CONSTRUCTION DOCUMENT

DRAWING #: RP1-100-190

ASBUILT DATE: NEEDS TO BE