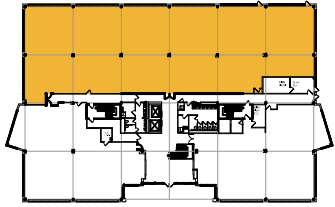
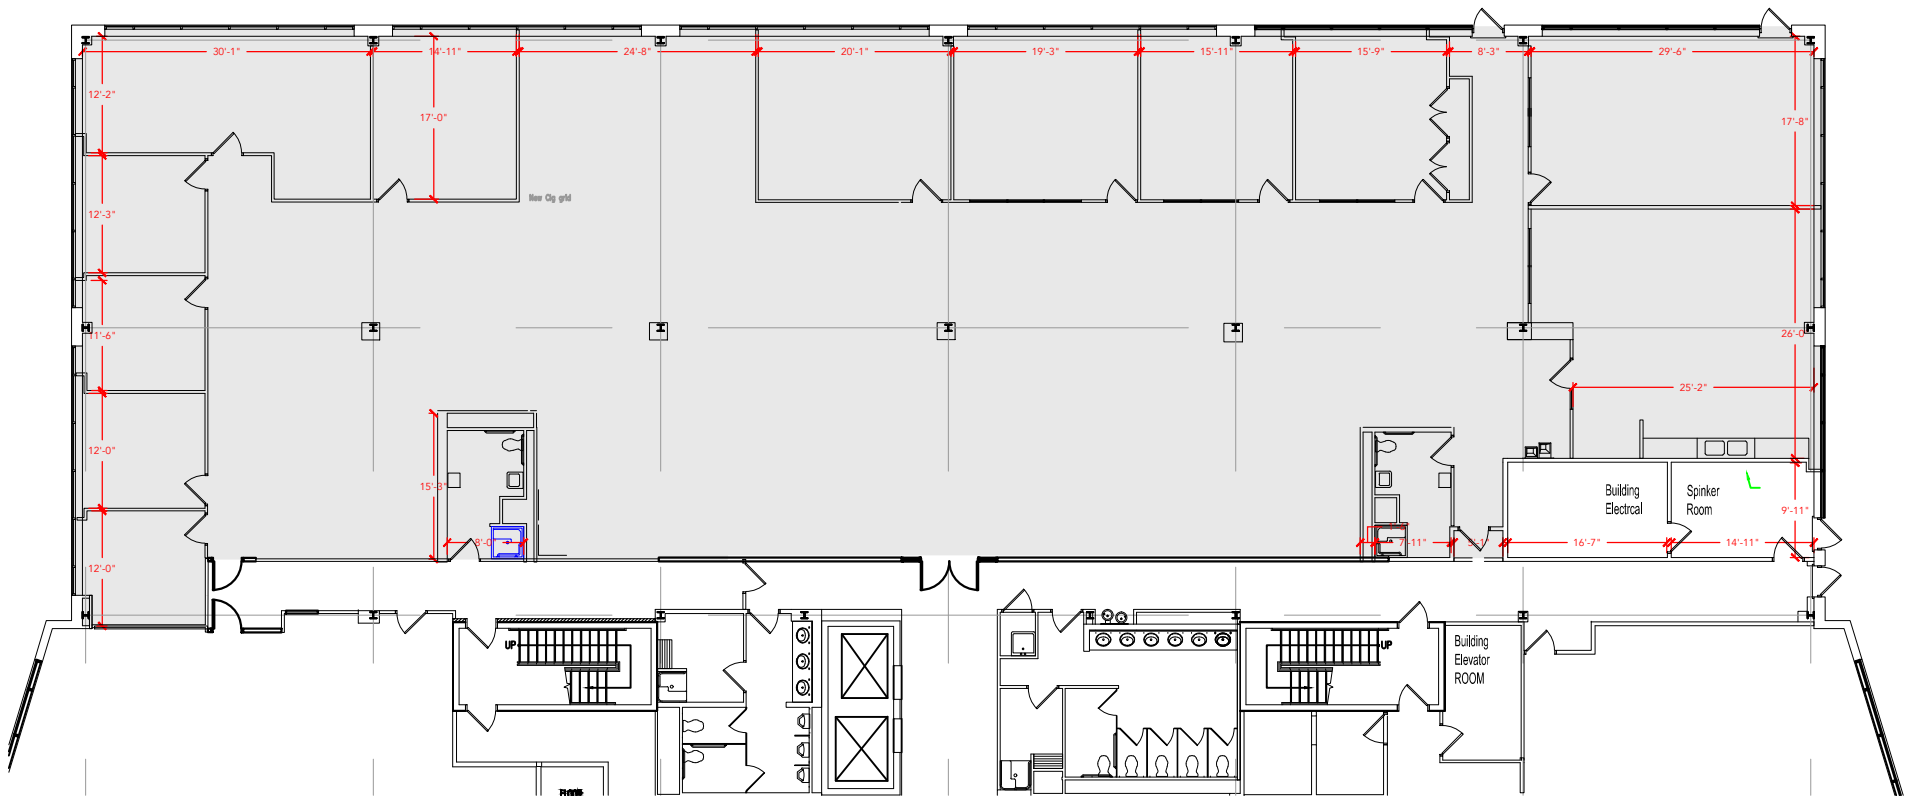


TOTAL SF AVAILABLE - 10,983 (12%)[Click to access 3D model](#)**Key Plan**

Floor Plan