



TOTAL SF AVAILABLE -23,775 RSF (12%)

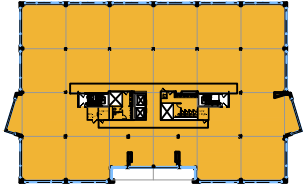

THIRD FLOOR

[Click to access 3D model](#)

Key Plan

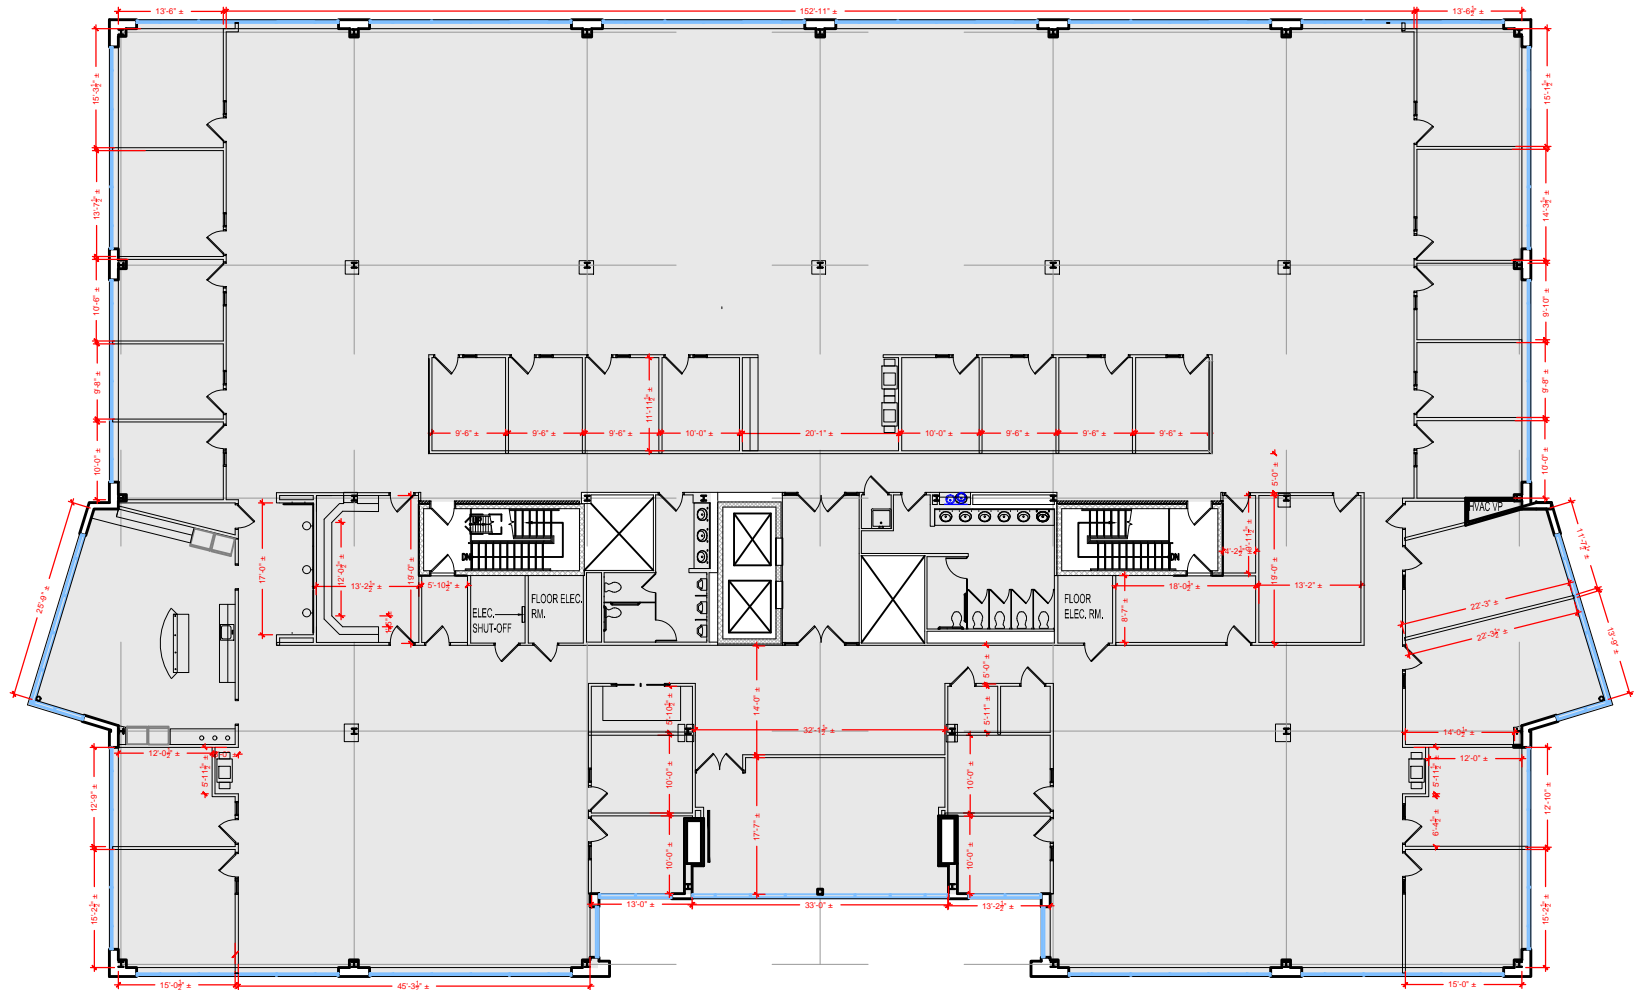

Floor Plan