


TOTAL SF AVAILABLE - 3,742 RSF(16%)



[Click to access 3D model](#)

Key Plan

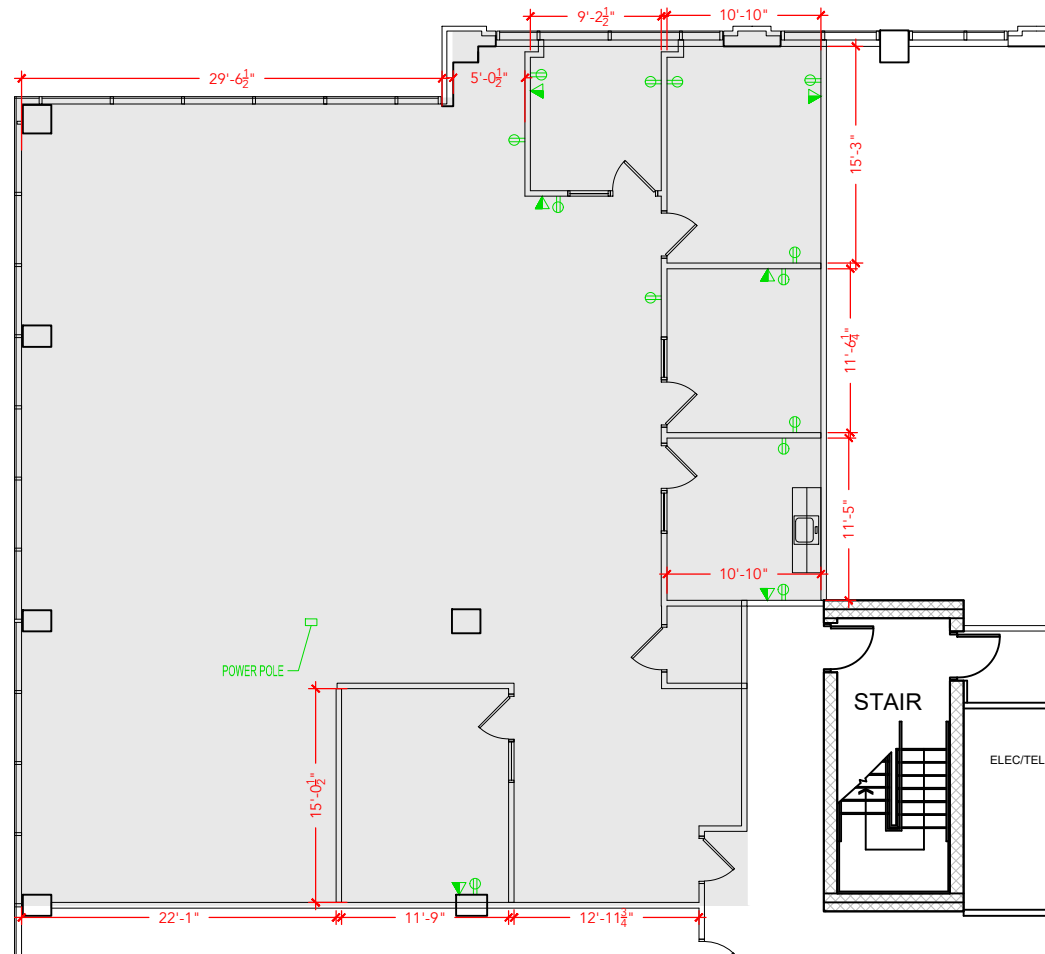

Floor Plan