



TOTAL SF AVAILABLE -3,761 RSF (16%)

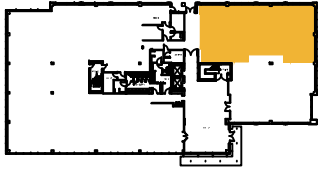

Key Plan

[Click to access CADD file](#)

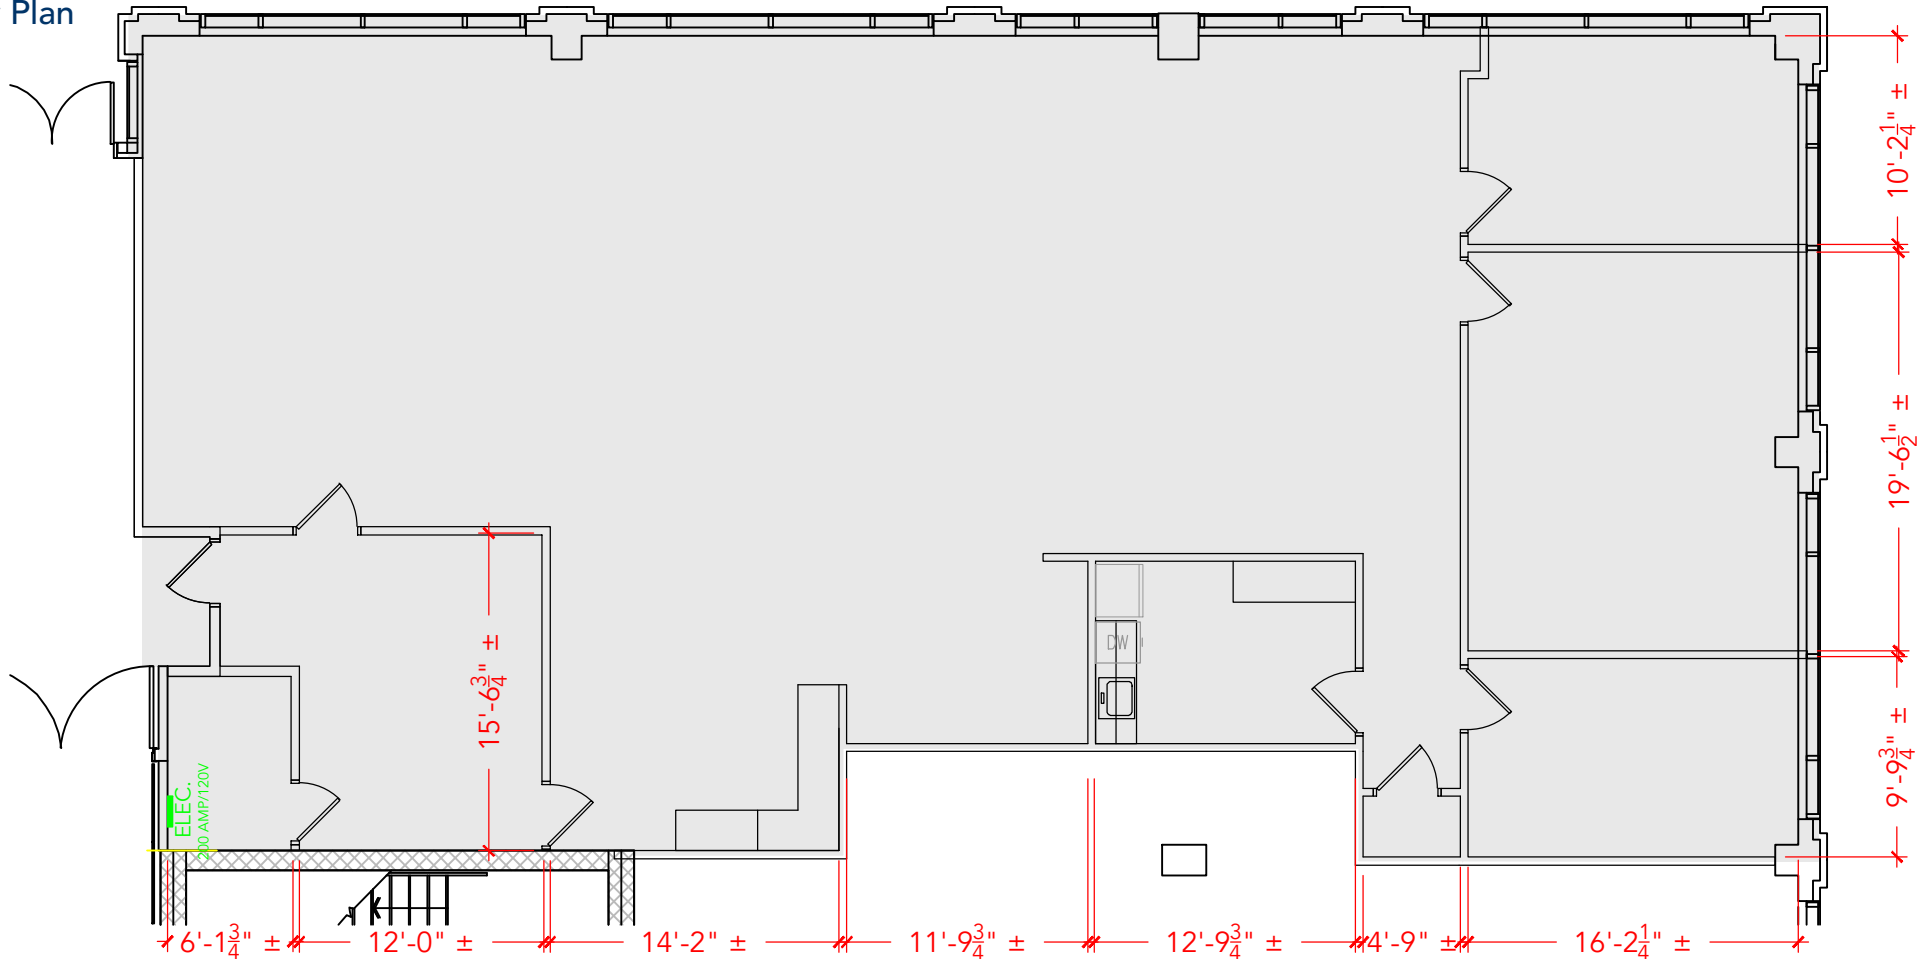

Floor Plan